SURVEY & REMONUMENTATION

APR 2 9 1996

COMMISSION

JUDITH D. ROEHM 11/08/95
Ontonagon County 14:38
LC 3/ 407 JEM Fee: 9.00
Page 1 of 1

LAND CORNER RECORDATION CERTIFICATE

Filing Requirement of Act 74, Mich. P.A. 1970

For corners in Ontonagon (County) Located In: Corner Code #

1. Public Land Survey		T 48N	R42W	A-9
		T ____	R ____	
		T 48N	R 43W	M-9
		T ____	R ____	
2. Property Controlling	S ____	T ____	R ____	
in Section	S ____	T ____	R ____	
3. Miscellaneous	S ____	T ____	R ____	
Property in Section	S ____	T ____	R ____	

Register of Deeds Stamp & File Number

4. Lot No. _____, Recorded Plat _____
5. Private Claims _____

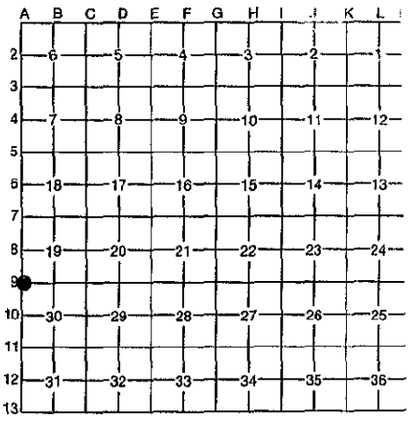

I, John R. Garske, in a field survey on November 6, 19 95, do hereby certify that under requirements of P.A. 74, Michigan P.A. of 1970, the corner points mentioned in lines 1 and 2 above were in conformance with regulations and rules therefore as required in the current manual of survey instructions of the United States Department of the Interior, Bureau of Land Management or by a decree of a Court of Law and/or that the corner points mentioned in lines 3, 4 and 5 above were in conformance with the rules of the Michigan Board of Professional Surveyors or by a Decree of a Court of Law; established, re-established, monumented, re-monumented, recovered, found as expressed below:

NOTE: Not more than 4 corners, all in the same town and range, may be recorded on this certificate.

A. Description of original monument and accessories and/or subsequent restoration:

- Original survey by John and William Burt, Deputy Surveyors, in August 1847. Set a sugar post from which:

  8" hemlock - S60°E, 28 links
  8" maple - N25°W, 6 links

- M.D.O.T. Highway Plans show corner at 0.9' east of highway centerline (iron rod)

- 1952 Plat of "Finn & Feathers" shows corner 1.2' east of centerline.

B. Description of corner evidence found and/or method applied in restoring or reestablishing corner:

I found a 3/4" diameter iron rod in a monument box, 0.9' east of the centerline of Highway M-64 as shown on the highway plans. I also found a 6" diameter concrete monument due east 78.30 feet. This corner position is commonly used and accepted and I am accepting it as marking the true corner position.

(Record research on file)

C. Description of monument for corner and accessories established to perpetuate locating the position of the corner:

I set a 3" diameter brass cap on the iron rod found and stamped it to identify the corner from which I established:

- Reference monument - Set a 3" diameter aluminum cap on the found concrete monument stamped due west - 78.30 feet to corner.
- 20" S. maple - N48°E - 54.48 feet.
- Twin 5" S. maple - S51°E - 80.60 feet
- Steel sign rail - Due East - 49.08 feet

PEER GROUP APPROVED
Paul Applekamp
COUNTY REPRESENTATIVE
11-06-95

STATE OF MICHIGAN
JOHN R. GARSKE
LAND SURVEYOR
No. 28410
LICENSED LAND SURVEYOR

Signed by John R Garske Date 11-6-95

Surveyor's Michigan License No. 28410

FORM APPROVED BY MICHIGAN STATE BOARD OF PROFESSIONAL SURVEYORS, JAN. 28, 1971
REVISED MAY 14, 1975
REVISED JAN., 1983

FED Index No. R-1