

SURVEY & REMONUMENTATION

APR 29 1996

JUDITH D. ROEHM
 Ontonagon County
 LC 3/ 376 MEL Fee: 9.00
 10/26/95
 14:11
 Page 1 of 1

LAND CORNER RECORDATION CERTIFICATE

Filing Requirement of Act 74, Mich. P.A. 1970

COMMISSION

For corners in ONTONAGON
 (County)

Located in:

Corner Code #

- | | | |
|--------------------------------------|-------------------------|--------------|
| 1. Public Land Survey | T <u>49</u> R <u>42</u> | <u>B-13</u> |
| | T <u>48</u> R <u>42</u> | <u>B-1</u> ✓ |
| | T _____ R _____ | _____ |
| | T _____ R _____ | _____ |
| 2. Property Controlling in Section | S _____ T _____ R _____ | _____ |
| | S _____ T _____ R _____ | _____ |
| 3. Miscellaneous Property in Section | S _____ T _____ R _____ | _____ |
| | S _____ T _____ R _____ | _____ |

Register of Deeds Stamp & File Number

4. Lot No. _____, Recorded Plat _____
 5. Private Claims _____

$\frac{1}{4}$ Corner common to Section 6, T48N R42W & Section 31, T49N R42W.

A	B	C	D	E	F	G	H	I	J	K	L	M
2	6	5	4	3	2	1						
3												
4	7	8	9	10	11	12						
5												
6	18	17	16	15	14	13						
7												
8	19	20	21	22	23	24						
9												
10	30	29	28	27	26	25						
11												
12	31	32	33	34	35	36						
13												

I, Earl W. Applekamp, in a field survey on August 30, 19 95 do hereby certify that under requirements of P.A. 74, Michigan P.A. of 1970, the corner points mentioned in lines 1 and 2 above were in conformance with regulations and rules therefore as required in the current manual of survey instructions of the United States Department of the Interior, Bureau of Land Management or by a decree of a Court of Law and/or that the corner points mentioned in lines 3, 4 and 5 above were in conformance with the rules of the Michigan Board of Professional Surveyors or by a Decree of a Court of Law; established, re-established, monumented, re-monumented, recovered, found as expressed below:

NOTE: Not more than 4 corners, all in the same town and range, may be recorded on this certificate.

A. Description of original monument and accessories and/or subsequent restoration:

Original corner established by William A. Burt, U.S. Deputy Surveyor, August 1848. Set Ironwood Post.

ORIGINAL BEARING TREES:

Sugar 8" N59°E 29 links (19.14 feet)
 Lynn 8" N38°W 19 links (12.54 feet)

B. Description of corner evidence found and/or method applied in restoring or reestablishing corner:

No original evidence was found. Found a 12" Ash with blazes 18 feet from corner. Blue paint running East from 12" ash. Corner was re-established by single proportionate measurement between opposite section corners East & West.

Research on file with County Remonumentation Program Representative.


PEER GROUP APPROVED

Earl W. Applekamp 10-18-95
 COUNTY REPRESENTATIVE

C. Description of monument for corner and accessories established to perpetuate locating the position of the corner:

At the corner position I set a 2 $\frac{1}{2}$ "x30" aluminum pipe with a 3 $\frac{1}{4}$ " cap stamped to read: T48N T49N R42W, $\frac{1}{4}$, S.31, S.6, 1995, P.S. 17610. I established the following bearing trees and reference objects:

12" Ash S03°E 32.26 feet - 7" Maple N50°E 10.20 feet
 10" Maple S82°W 33.94 feet - Steel Sign Post North 1.20 feet

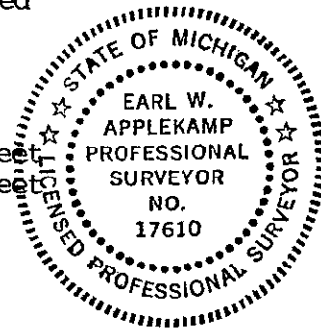

Signed by Earl W. Applekamp
 Surveyor's Michigan License No. 17610

Date October 03, 1995