

**SURVEY & REMONUMENTATION**

APR 25 1995

**COMMISSION**

**LAND CORNER RECORDATION CERTIFICATE**  
**Filing Requirement of Act 74, Mich. P.A. 1970**

For corners in Ontonagon  
 (County)

	Located In:	Corner Code #
1. Public Land Survey	T <u>48N</u> R <u>42W</u>	<u>E-8</u>
	T _____ R _____	_____
	T _____ R _____	_____
	T _____ R _____	_____
2. Property Controlling in Section	S _____ T _____ R _____	_____
	S _____ T _____ R _____	_____
3. Miscellaneous Property in Sec.	S _____ T _____ R _____	_____
	S _____ T _____ R _____	_____
4. Lot No. _____, Recorded Plat _____		
5. Private Claims _____		

Recorded August 31 1994  
 at 2:05 o'clock P. M. in  
 Liber 3 page 208  
*Julie Macky* Deputy  
 Register of Deeds

Register of Deeds Stamp & File Number

	A	B	C	D	E	F	G	H	I	J	K	L	M
2	6	5	4	3	2	1							
3													
4	7	8	9	10	11	12							
5													
6	18	17	16	15	14	13							
7													
8	19	20	21	22	23	24							
9													
10	30	29	28	27	26	25							
11													
12	31	32	33	34	35	36							
13													

I, John R. Garske, in a field survey on May 19, 1994, do hereby certify that under requirements of P.A. 74, Michigan P.A. of 1970, the corner points mentioned in lines 1 and 2 above were in conformance with regulations and rules therefore as required in the current manual of survey instructions of the United States Department of the Interior, Bureau of Land Management or by a decree of a Court of Law and/or that the corner points mentioned in lines 3, 4 and 5 above were in conformance with the rules of the Michigan Board of Land Surveyors or by a Decree of a Court of Law; established, re-established, monumented, re-monumented, recovered, found as expressed below:

**NOTE: Not more than 4 corners, all in the same town and range, may be recorded on this certificate.**

A. Description of original monument and accessories and/or subsequent restoration:

Original survey by Austin Burt, U.S.D.S. on August 2-12, 1848. Set a post. Set B. ash post.  
 Original Bearing Trees:  
 8" hemlock - S26°E - 26 links; 10" hemlock - N29°W - 26 links

B. Description of corner evidence found and/or method applied in restoring or reestablishing corner:

I found no original evidence of the corner. I re-established the corner by standard sectional subdivision by single proportional measurement. Corner position is consistent with G.L.O. calls. I monumented the corner and updated accessories to state and county specifications as noted below.

Research on file with County Representative.


**ONTONAGON COUNTY**  
**PEER APPROVED**

*Earl Applekamp* Co. Rep.  
 8-17-94

C. Description of monument for corner and accessories established to perpetuate locating the position of the corner:

I set 1-4 foot section of 3/4" diameter aluminum rod with a 3 1/4" aluminum cap stamped: 1/4, S-20, S-21, T48N, R42W, 1994, RLS 28410. I established the following bearing trees and reference objects:

- Steel sign post - N55°E - 1.10 feet
- 8" hemlock - N46°W - 4.98 feet
- 10" cedar - S45°W - 14.76 feet
- 5" hemlock - S64°E - 8.82 feet

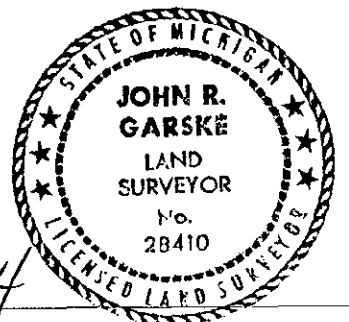

Signed by John R Garske Date 6/8/94  
 Surveyor's Michigan License No. 28410

FORM APPROVED BY MICHIGAN STATE BOARD OF LAND SURVEYORS, JAN. 28, 1971  
 REVISED MAY 14, 1975  
 REVISED JAN., 1983