

# SURVEY & REMONUMENTATION

APR 25 1995

## LAND CORNER RECORDATION CERTIFICATE Filing Requirement of Act 74, Mich. P.A. 1970

For corners in  
**COMMISSION**  
Ontonagon  
(County)


	Located In:	Corner Code #
1. Public Land Survey	T <u>48N</u> R <u>42W</u>	<u>E-9</u>
	T _____ R _____	_____
	T _____ R _____	_____
	T _____ R _____	_____
2. Property Controlling in Section	S _____ T _____ R _____	_____
	S _____ T _____ R _____	_____
3. Miscellaneous Property in Sec.	S _____ T _____ R _____	_____
	S _____ T _____ R _____	_____

Recorded August 31 1994  
at 2:05 o'clock P. M. in  
Libel 3 page 209  
*Julie M. Abery, Register*  
Register of Deeds

Register of Deeds Stamp & File Number

4. Lot No. \_\_\_\_\_, Recorded Plat \_\_\_\_\_  
5. Private Claims \_\_\_\_\_

I, John R. Garske, in a field survey on May 2, 1994, do hereby certify that under requirements of P.A. 74, Michigan P.A. of 1970, the corner points mentioned in lines 1 and 2 above were in conformance with regulations and rules therefore as required in the current manual of survey instructions of the United States Department of the Interior, Bureau of Land Management or by a decree of a Court of Law and/or that the corner points mentioned in lines 3, 4 and 5 above were in conformance with the rules of the Michigan Board of Land Surveyors or by a Decree of a Court of Law; established, re-established, monumented, re-monumented, recovered, found as expressed below:

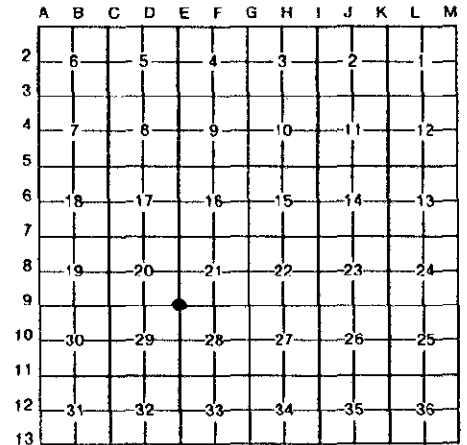

**NOTE: Not more than 4 corners, all in the same town and range, may be recorded on this certificate.**

A. Description of original monument and accessories and/or subsequent restoration:  
**Original survey by Austin Burt, U.S.D.S., on August 2-12, 1848. Set maple post. Original Bearing Trees: 24" hemlock - S55°E - 7 links; 10" hemlock - N57°W - 20 links**  
**Keweenaw Land Assoc. Ltd. - Location poster on 14" cedar dated 3/17/93 and K.L.A. tag on 8" hemlock faces west to cedar.**  
**1983 and 1985 surveys by E.W. Applekamp, RLS 17610 - Corner marked by a 1" drill steel and witnessed by 12" cedar - N82°W - 19.94 feet; 8" hemlock - S12°W - 10.45 feet; 6" hemlock - N30°E - 34.90 feet**  
**1986 survey by John R. Garske, RLS 28410 - found 1" drill steel as called out in Applekamp surveys**

B. Description of corner evidence found and/or method applied in restoring or reestablishing corner:  
**I found a 1" drill steel marking the corner position as described above. I accepted this position as being true due to its use in many surveys of record by various surveyors and longevity. I remonumented corner and updated the accessories to state and county specifications as noted below.**

Research on file with County Representative.

**ONTONAGON COUNTY  
PEER APPROVED**

*Earl Applekamp Co. Rep.*  
8-17-94

C. Description of monument for corner and accessories established to perpetuate locating the position of the corner:

**I set a 2 1/2" x 1.4' long aluminum flanged pipe with a 3 1/4" aluminum cap over the found 1" drill steel and anchored it with concrete. Aluminum cap is stamped: County Monumentation; S-20, S-21, S-28, S-29, T48N, R42W, 1994, RLS 28410. I established the following bearing trees and reference objects:**

- Steel sign post - S53°E - 0.78 feet
- 16" S. maple - N46°W - 22.42 feet
- 7" S. maple - S08°W - 20.21
- 8" hemlock - N80°E - 37.45 feet
- 14" hemlock - S41°E - 16.65 feet

Signed by John R. Garske Date 6/8/94  
Surveyor's Michigan License No. 28410



FORM APPROVED BY MICHIGAN STATE BOARD OF LAND SURVEYORS, JAN. 28, 1971  
REVISED MAY 14, 1975  
REVISED JAN., 1983