

SURVEY & REMONUMENTATION

APR 29 1996

COMMISSION

JUDITH D. ROEHM 11/08/95
Ontonagon County 14:40
LC 3/410 JEM Fee: 9.00
Page 1 of 1

LAND CORNER RECORDATION CERTIFICATE Filing Requirement of Act 74, Mich. P.A. 1970

For corners in

	Located In:	Corner Code #
_____ <u>Ontonagon</u> _____ <small>(County)</small>		
1. Public Land Survey	T <u>48N</u> R <u>42W</u>	<u>F-9</u>
	T _____ R _____	_____
	T _____ R _____	_____
	T _____ R _____	_____
2. Property Controlling in Section	S _____ T _____ R _____	_____
	S _____ T _____ R _____	_____
3. Miscellaneous Property in Sec.	S _____ T _____ R _____	_____
	S _____ T _____ R _____	_____

Register of Deeds Stamp & File Number

4. Lot No. _____, Recorded Plat _____
5. Private Claims _____

One-quarter corner common to Sections 21 & 28, T48N, R42W

I, John R. Garske, in a field survey on November 1, 19 95, do hereby certify that under requirements of P.A. 74, Michigan P.A. of 1970, the corner points mentioned in lines 1 and 2 above were in conformance with regulations and rules therefore as required in the current manual of survey instructions of the United States Department of the Interior, Bureau of Land Management or by a decree of a Court of Law and/or that the corner points mentioned in lines 3, 4 and 5 above were in conformance with the rules of the Michigan Board of Land Surveyors or by a Decree of a Court of Law; established, re-established, monumented, re-monumented, recovered, found as expressed below:

NOTE: Not more than 4 corners, all in the same town and range, may be recorded on this certificate.

	A	B	C	D	E	F	G	H	I	J	K	L	M
2	6	5	4	3	2	1							
3													
4	7	8	9	10	11	12							
5													
6	18	17	16	15	14	13							
7													
8	19	20	21	22	23	24							
9													
10	30	29	28	27	26	25							
11													
12	31	32	33	34	35	36							
13													

A. Description of original monument and accessories and/or subsequent restoration:

- Survey by Austin Burt, Deputy Surveyor, 1848 - Set sugar post from which:

- Fir 8 - S45°W, 35 links (23.1 feet)
- Hemlock 12 - N25°E, 15 links (9.90 feet)

B. Description of corner evidence found and/or method applied in restoring or reestablishing corner:

Taping east from the monumented corner at 20, 21, 28 and 29, I established a search area at the one-quarter corner. I recovered the hemlock B.T. now a 24"- 30" decayed stump. This corner position is N89°-59'-56"E, 2632.03 feet from the N.W. corner of Section 28. The position matches very good with the 990 foot call east to a swamp which is an abrupt thick cedar swamp. Taping west 722 feet I recovered a 24" ± yellow birch stump (decayed) at record distance for the line tree, originally a 10" Y. birch, from my corner position.

This corner position is approximately S2°W - 16 feet from a blazed and painted tree Keweenaw is using as the one-quarter corner.

(Record research is on file)

C. Description of monument for corner and accessories established to perpetuate locating the position of the corner:


I set a 3/4" diameter x 4 foot long aluminum rod with a 3" aluminum cap stamped T48N, R42W, one-quarter corner, S-21, S-28, 1995, RLS 28410, from which I established the following bearing trees/objects:

- 12" maple - N26°W - 11.55 feet
- 12" maple - S51°E - 11.40 feet
- 12" maple - S56°W - 19.12 feet
- Steel rail with sign - N60°E - 1.48 feet

PEER GROUP APPROVED

Paul Applekamp
COUNTY REPRESENTATIVE

11-06-95

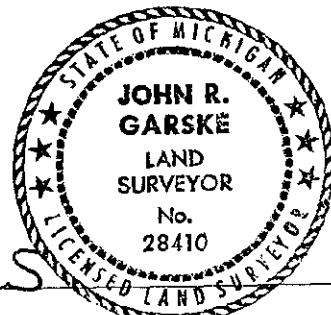

Signed by _____

John R. Garske

Date 11-6-95

Surveyor's Michigan License No. 28410