

LAND CORNER RECORDATION CERTIFICATE of 1

LC 5/258

Filing Requirement of Act 74, Mich. P.A. 1970

12/21/1999

Time 11:12:34

RECORDING FEE:

9.00

For corners in

Ontonagon County	Located in:	Corner Code #
1. Public Land Survey	T48N R42W	G - 4
	T R	
	T R	
	T R	
2. Property Controlling in Section	S T R	
	S T R	
3. Miscellaneous Property in Sec.	S T R	
	S T R	
4. Lot No.		Recorded Plat
5. Private Claims		

SURVEY & REMONUMENTATION

MAR 23 2000

SECTION

Register of Deeds Stamp & File Number

	A	B	C	D	E	F	G	H	I	J	K	L	M
1													
2	6	5	4	3	2	1							
3													
4	7	8	9	10	11	12							
5													
6	18	17	16	15	14	13							
7													
8	19	20	21	22	23	24							
9													
10	30	29	28	27	26	25							
11													
12	31	32	33	34	35	36							
13													

I, Joseph C. Domitrovich, in a field survey on November 8, 1999, do hereby state that under requirements of P.A. 74, Michigan P.A. of 1970, the corner points mentioned in lines 1 and 2 above were in conformance with regulations and rules therefore as required in the current manual of survey instructions of the United States Department of the Interior, Bureau of Land Management or by a decree of a Court of Law and /or that the corner points mentioned in lines 3, 4 and 5 above were in conformance with the rules of the Michigan Board of Land Surveyors or by a Decree of a Court of Law; established, re-established, monumented, recovered, found as expressed below:

NOTE: Not more than 2 corners, all in the same town and range, may be recorded on this certificate.

A. Description of original monument and accessories and/or subsequent restoration:

(G - 4) 1/4 Corner Common to Sections 9 & 10, T48N, R42W

1848 Austin Burt set a Cedar post with ties:

12" Sugar	S 37°E	24 links
14" Lynn	N 28°W	27 links

No Record of subsequent restoration.

B. Description of corner evidence found and/or method applied in restoring or reestablishing corner:

I found no remains of the original corner or accessories. At the 1/4 corner position I found a 1" iron pipe 15' west of centerline of an old logging road. This pipe falls within 5.6' of a single prorated position and appears to have been used and accepted as the 1/4 corner for many years. I have accepted the 1" iron pipe as best representing the original position of the GLO 1/4 corner. I placed a 3/4" aluminum rod with cap inside of the existing pipe.

Research on file with County Remonumentation Representative.


PEER GROUP APPROVED
Paul W. Applekamp
COUNTY REMONUMENTATION

12-20-99

C. Description of monument for corner and accessories established to perpetuate locating the position of the corner:

Corner is a 3/4" x 48" aluminum rod with a 3" aluminum cap stamped to read: COUNTY REMONUMENTATION, T48N, R42W; 1/4; S. 9, S. 10; 1999; P.S. 37273. Ties:

7" Spruce	N 45°W	24.98'
14" Soft Maple	N 82°W	33.06'
Steel sign rail	South	.73' (to face)
6" Soft Maple	S 63°E	35.45'
12" Ash	N 68°E	42.40'

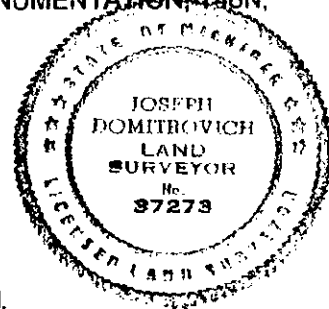

NOTE: Bearings to witness objects are magnetic. Distances are to a nail in side of the witness object unless noted.

Signed by Joseph C. Domitrovich

Date 12/14/99

Surveyor's Michigan License No. 37273