

For corners in

Ontonagon County	Located in:	Corner Code #
1. Public Land Survey	T48N R42W	G - 5
	T R	
	T R	
	T R	
2. Property Controlling in Section	S T R	
	S T R	
3. Miscellaneous Property in Sec.	S T R	
	S T R	
4. Lot No. , Recorded Plat		
5. Private Claims		

SURVEY & REMONUMENTATION
MAR 23 2000
SECTION

Register of Deeds Stamp & File Number

	A	B	C	D	E	F	G	H	I	J	K	L	M
1													
2	6	5		4			3		2			1	
3													
4	7	8	9	10					11			12	
5							●						
6	18	17	16	15	14	13							
7													
8	19	20	21	22	23	24							
9													
10	30	29	28	27	26	25							
11													
12	31	32	33	34	35	36							
13													

I, Joseph C. Domitrovich, in a field survey on November 8, 1999, do hereby state that under requirements of P.A. 74, Michigan P.A. of 1970, the corner points mentioned in lines 1 and 2 above were in conformance with regulations and rules therefore as required in the current manual of survey instructions of the United States Department of the Interior, Bureau of Land Management or by a decree of a Court of Law and /or that the corner points mentioned in lines 3, 4 and 5 above were in conformance with the rules of the Michigan Board of Land Surveyors or by a Decree of a Court of Law; established, re-established, monumented, recovered, found as expressed below:

NOTE: Not more than 2 corners, all in the same town and range, may be recorded on this certificate.

A. Description of original monument and accessories and/or subsequent restoration:

(G - 5) Corner Common to Sections 9, 10, 15, & 16, T48N, R42W

1848 Austin Burt set a post with ties:

16" Sugar Maple	S 43°W	17 links
16" Elm	N 38°W	32 links

1968 Donald Lappala, P.S. 12585, found a 3" x 3" x 60" wood post and two original "B.T." He re-set the corner with a 2" inside diameter by 5' concrete filled galvanized iron pipe, capped with a 3" circular bronze tablet stamped to read: T.48N., R.42W.; S -9, S -10, S - 15, S - 16; R.L.S. 12585; 1968. Ties:

5" Sugar Maple	N 39°W	34.8'
7" Sugar Maple	N 25°E	31.4'
5" Sugar Maple	S 26°W	10.7'

B. Description of corner evidence found and/or method applied in restoring or reestablishing corner:

I recovered the 2" capped pipe called for by Lappala and three of his bearing trees. The original 12" Elm B.T. is now rotted to ground level. I found no remains of the sugar B.T. I added a steel sign rail and one bearing tree as accessories to Lappala's monument.


Research on file with County Remonumentation Representative.

DEED GROUP APPROVED
Earl W. Applekamp
 COUNTY REGISTER
 12-20-99

C. Description of monument for corner and accessories established to perpetuate locating the position of the corner:

Corner is a 2" x 60" concrete-filled pipe with a 3" circular bronze tablet stamped to read: T.48N., R.42W.; S -9, S -10, S - 15, S - 16; R.L.S. 12585; 1968. Ties:

7" Hard Maple	N 37°W	34.77' (Existing - added nail)
Steel sign rail	West	1.53' (to face)
8" Hard Maple	S 29°W	10.68' (Existing - added nail)
7" Hard Maple	S 38°E	3.31'
8" Hard Maple	N 29°E	31.55' (Existing - added nail)

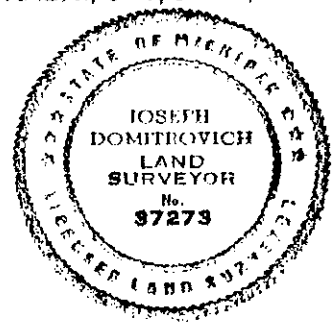

NOTE: Bearings to witness objects are magnetic. Distances are to a nail in side of the witness object unless noted.

Signed by *J. C. Domitrovich*

Date 12/14/99

Surveyor's Michigan License No. 37273