

**SURVEY & REMONUMENTATION**

APR 25 1995

**LAND CORNER RECORDATION CERTIFICATE**  
**Filing Requirement of Act 74, Mich. P.A. 1970**

**COMMISSION**

For corners in Ontonagon/Gogebic  
 (County)

Located In: \_\_\_\_\_ Corner Code # \_\_\_\_\_

Recorded December 7 1994  
 at 4:15 o'clock P. M. In  
 Liber 3 page 238  
*Janis Marky*  
 Register of Deeds

- |                                    |                           |               |
|------------------------------------|---------------------------|---------------|
| 1. Public Land Survey              | T <u>48N</u> R <u>42W</u> | <u>G-13</u> ✓ |
|                                    | T _____ R _____           | _____         |
|                                    | T <u>47N</u> R <u>42W</u> | <u>G-01</u>   |
|                                    | T _____ R _____           | _____         |
| 2. Property Controlling in Section | S _____ T _____ R _____   | _____         |
|                                    | S _____ T _____ R _____   | _____         |
| 3. Miscellaneous Property in Sec.  | S _____ T _____ R _____   | _____         |
|                                    | S _____ T _____ R _____   | _____         |

Register of Deeds Stamp & File Number

4. Lot No. \_\_\_\_\_, Recorded Plat \_\_\_\_\_
5. Private Claims \_\_\_\_\_  
 Section corner common to Sections 33 and 34, T48N, R42W and Sections 4 and 3, T47N, R42W.

	A	B	C	D	E	F	G	H	I	J	K	L	M
2	6	5	4	3	2	1							
3													
4	7	8	9	10	11	12							
5													
6	18	17	16	15	14	13							
7													
8	19	20	21	22	23	24							
9													
10	30	29	28	27	26	25							
11													
12	31	32	33	34	35	36							
13													

I, John R. Garske, in a field survey on October 29, 1994, do hereby certify that under requirements of P.A. 74, Michigan P.A. of 1970, the corner points mentioned in lines 1 and 2 above were in conformance with regulations and rules therefore as required in the current manual of survey instructions of the United States Department of the Interior, Bureau of Land Management or by a decree of a Court of Law and/or that the corner points mentioned in lines 3, 4 and 5 above were in conformance with the rules of the Michigan Board of Land Surveyors or by a Decree of a Court of Law; established, re-established, monumented, re-monumented, recovered, found as expressed below:

**NOTE: Not more than 4 corners, all in the same town and range, may be recorded on this certificate.**

A. Description of original monument and accessories and/or subsequent restoration:

Survey by John and Wm. Burt on August 10-14, 1847. Set a cedar post from which a 18" sugar bears N54°E, 28 links and a 14" sugar - N59°W, 20 links.

1964 plat of Lake Gogebic East Shore Subdivision No. 1 - Shows corner position.

1990 survey by John R. Garske found 1" drill rod and witnessed 6" ash - N30°W, 7.12 feet; 10" ash - S76°E, 7.04 feet; 7" ash - S60°W, 6.09 feet. Corner checks against 1964 plat as noted above. Recorded in L. 3, Pg. 369 in Gogebic County Register of Deeds Office.

B. Description of corner evidence found and/or method applied in restoring or reestablishing corner:

Found 1" drill rod as noted above. Dimensions along the section line check with recorded plat dimensions. Accepted corner position as being in the correct corner location due to its use by other surveyors and the development referenced to it.

Act 74 record research on file.

**ONTONAGON COUNTY**  
**PEER APPROVED**


*Earl W. Koppelman*  
 Co. Rep.  
 11-30-94

C. Description of monument for corner and accessories established to perpetuate locating the position of the corner:

I updated the corner position to state and county specifications by replacing the 1" drill rod with a 2 1/2" x 30" aluminum pipe with a 3 1/4" aluminum cap stamped: County Remonumentation; S-33; S-34; S-4; S-3; T48-47N, R42W; 1994; RLS 28410. I established the following bearing trees and reference objects: 10" ash - S76°E, 7.04 feet; 7" ash - S60°W, 6.09 feet; 6" ash - N30°W, 7.12 feet; 6 foot steel rail with sign - N32°E, 1.67 feet.

Signed by John R. Garske  
 Surveyor's Michigan License No. 28410

Date 11/8/94

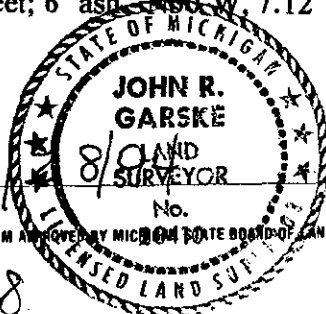

FORM APPROVED BY MICHIGAN STATE BOARD OF LAND SURVEYORS, JAN. 28, 1971  
 REVISED MAY 14, 1975  
 REVISED JAN., 1983