

SURVEY & REMONUMENTATION

APR 29 1996

COMMISSION

JUDITH D. ROEHM
 Ontonagon County
 LC 3/ 286 JEM Fee: 9.00
 08/09/95
 13:32
 Page 1 of 1

LAND CORNER RECORDATION CERTIFICATE

Filing Requirement of Act 74, Mich. P.A. 1970

For corners in ONTONAGON Located In: _____ Corner Code # _____
(County)


- | | | |
|--------------------------------------|-------------------------|---------|
| 1. Public Land Survey | T 48 R41 | A-3 |
| | T 48 R 42 | (M-3) ✓ |
| | T _____ R _____ | _____ |
| | T _____ R _____ | _____ |
| 2. Property Controlling in Section | S _____ T _____ R _____ | _____ |
| | S _____ T _____ R _____ | _____ |
| 3. Miscellaneous Property in Section | S _____ T _____ R _____ | _____ |
| | S _____ T _____ R _____ | _____ |

Register of Deeds Stamp & File Number

4. Lot No. _____, Recorded Plat _____
 5. Private Claims _____

Section corner common to Sections 1, 6, 7 & 12, T48N R41W & R42W

I, Earl W. Applekamp, in a field survey on June 27, 19 95, do hereby certify that under requirements of P.A. 74, Michigan P.A. of 1970, the corner points mentioned in lines 1 and 2 above were in conformance with regulations and rules therefore as required in the current manual of survey instructions of the United States Department of the Interior, Bureau of Land Management or by a decree of a Court of Law and/or that the corner points mentioned in lines 3, 4 and 5 above were in conformance with the rules of the Michigan Board of Professional Surveyors or by a Decree of a Court of Law; established, re-established, monumented, re-monumented, recovered, found as expressed below:

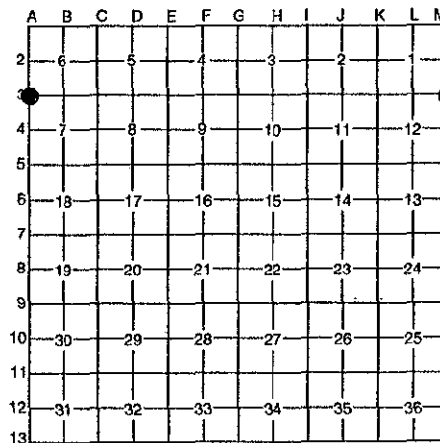

NOTE: Not more than 4 corners, all in the same town and range, may be recorded on this certificate.

A. Description of original monument and accessories and/or subsequent restoration:

Original corner established by William A. Burt, U.S. Deputy Surveyor, July 1857. Set Hemlock Post.

BEARING TREES:

Spruce 5" N11°E 27 Links (17.82 feet)
 Cedar 16" S85°W 15 Links (9.90 feet)

B. Description of corner evidence found and/or method applied in restoring or reestablishing corner:

No original evidence was found. The corner location is on a gravel road. A field is on the East side and a well maintained fence runs East from the location. A stream call 2.72 Chains South is in agreement with the fence line. At this location I set a monument and Witness corner described in "C" below. This corner is one of 29 corners in 6 Sections remonumented under the County Remonumentation Program. Research is on file with the Ontonagon County Remonumentation Program Representative.


PEER GROUP APPROVED

Earl W. Applekamp 8-08-95
COUNTY REPRESENTATIVE

C. Description of monument for corner and accessories established to perpetuate locating the position of the corner:

At the corner location I set a 3/4"x18" aluminum rod with a 3 1/4" cap 4" below the gravel road. The cap is stamped to read: COUNTY REMONUMENTATION, S1, S6, S7, S12, T48N R41W, R42W, 1995, P.S. 17610. I established the following bearing trees and reference objects:

8" Aspen N39°W 37.72 feet REA Power Pole S15°E 97.20 feet
 7" Elm S49°W 40.24 feet 2 1/2"x30" pipe with 3 1/4" cap W.C. West 26.71 feet

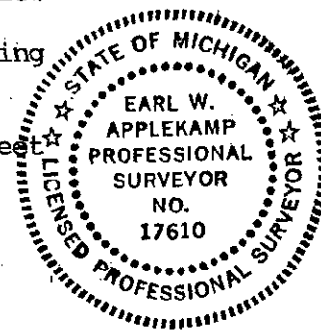

Signed by Earl W. Applekamp
 Surveyor's Michigan License No. 17610

Date June 27, 1995