


LAND CORNER RECORDATION CERTIFICATE
 Filing Requirement of Act 74, Mich. P.A. 1970

For corners in

<u>ONTONAGON</u> (County)	Located in:	Corner Code #
1. Public Land Survey	T48N R41W T48N R42W T___ R___ T___ R___	A-9 M-9 ✓
2. Property Controlling in Section	S___ T___ R___ S___ T___ R___	_____ _____
3. Miscellaneous Property in Sec.	S___ T___ R___ S___ T___ R___	_____ _____

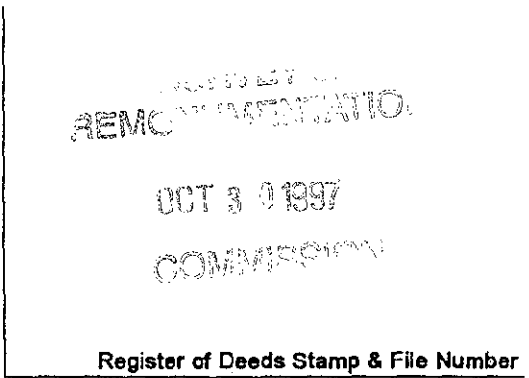

4. Lot No. _____, Recorded Plat _____
 5. Private Claims _____

1	A	B	C	D	E	F	G	H	I	J	K	L	M
2	6		5		4		3		2		1		
3													
4	7		8		9		10		11		12		
5													
6	18		17		16		15		14		13		
7													
8	19		20		21		22		23		24		
9													
10	30		29		28		27		26		25		
11													
12	31		32		33		34		35		36		
13													

Section Corner common to Sections 19 & 30, T48N R41W & 24 & 25, T48N R42W.

I, Earl W. Applekamp, in a field survey on Aug. 22, 1997 do hereby state that under requirements of P.A. 74, Michigan P.A. of 1970, the corner points mentioned in lines 1 and 2 above were in conformance with regulations and rules therefore as required in the current manual of survey instructions of the United States Department of the Interior, Bureau of Land Management or by a decree of a Court of Law and /or that the corner points mentioned in lines 3, 4 and 5 above were in conformance with the rules of the Michigan Board of Land Surveyors or by a Decree of a Court of Law; established, re-established, monumented, recovered, found as expressed below:

NOTE: Not more than 2 corners, all in the same town and range, may be recorded on this certificate.

A. Description of original monument and accessories and/or subsequent restoration:
 Original corner established by William A. Burt, U.S. Deputy Surveyor, August 12, 1847. Set Spruce Post.

ORIGINAL BEARING TREES:
 6" Tamarack N74°E 19.14 feet
 8" Spruce S30°W 7.92 feet

B. Description of corner evidence found and/or method applied in restoring or reestablishing corner:
 No original evidence was found. Corner position falls in a bog swamp in all directions from corner. Corner was re-established using the original calls from the corner East. This position is within 8 feet of the original call to the corner North. The position is in conformance with the feature calls from the original survey.

Research on file with the Ontonagon County Remonumentation Program Representative.

PEER GROUP APPROVED
Earl W. Applekamp
 COUNTY REPRESENTATIVE
 9-17-97

C. Description of monument for corner and accessories established to perpetuate locating the position of the corner:
 At the corner position I set a 3/4"X6" aluminum rod with a 3" cap stamped to read: County Remonumentation, T48N R41W, R42W, S19, S30, S24, S25, 1997, P.S. 17610. I established 3 bearing trees and a reference object.

4 1/2" Elm N09°-30'E 38.54' - 8" Elm S42°E 53.62'
 4" Elm N10°E 35.88' - Steel Sign Post, West 1.29'



Signed by Earl W. Applekamp Date September 16, 1997
 Surveyor's Michigan License No. 17610