

LAND CORNER RECORDATION CERTIFICATE
 Filing Requirement of Act 74, Mich. P.A. 1970

For corners in

<u>Ontonagon</u> (County)	Located In:	Corner Code #
1. Public Land Survey	T <u>48N</u> R <u>43W</u>	<u>A-13</u> ✓
	T _____ R _____	_____
	T _____ R _____	_____
Gogebic County	T <u>48N</u> R <u>44W</u>	<u>M-13</u>
2. Property Controlling	S _____ T <u>47N</u> R <u>44W</u>	<u>M-1</u>
in Section	S _____ T <u>47N</u> R <u>43W</u>	<u>A-1</u>
3. Miscellaneous	S _____ T _____ R _____	_____
Property in Sec.	S _____ T _____ R _____	_____

**SURVEY &
 REMONUMENTATION**

JAN 11 1999

SECTION


Register of Deeds Stamp & File Number

4. Lot No. _____, Recorded Plat _____
 5. Private Claims _____

Township Corner 31, 36, 1 & 4; T.47-48 N., R.43-44 W.

I, Richard L. Drahn in a field survey on April 29, 19 98, do hereby certify that under requirements of P.A. 74, Michigan P.A. of 1970, the corner points mentioned in lines 1 and 2 above were in conformance with regulations and rules therefore as required in the current manual of survey instructions of the United States Department of the Interior, Bureau of Land Management or by a decree of a Court of Law and/or that the corner points mentioned in lines 3, 4 and 5 above were in conformance with the rules of the Michigan Board of Land Surveyors or by a Decree of a Court of Law; established, re-established, monumented, re-monumented, recovered, found as expressed below:

NOTE: Not more than 4 corners, all in the same town and range, may be recorded on this certificate.

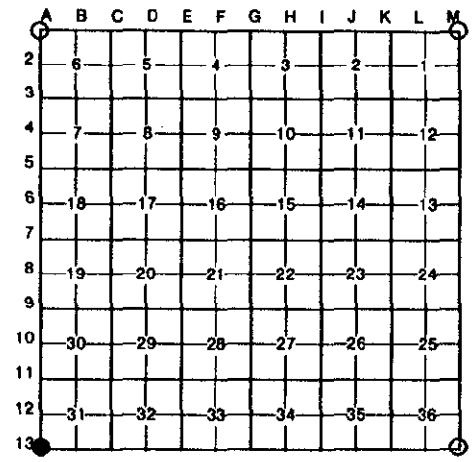

A. Description of original monument and accessories and/or subsequent restoration:

Corner established by John Burt on 8/11/1847. Original B.T.s ---Cedar 18" N.63 w. 14 links (9.24') --- Cedar 18" S.51 E. 33links (21.78')---
 Corner restored by Richard L. Drahn (21564) on 9/24/81 from the remains of the first B.T. He set a 2" X 30" aluminum pipe with a 3½" stamped aluminum cap and the following new bearing trees:
 9" Cedar N.45 W. 6.98'
 9" Red Maple S.32 W. 16.56'
 15" Yellow Birch S.62 E. 39.01'
 6' Steel sign rail N.28 W. 1.7'

Corner (recorded in Gogebic County Liber 2, Page 138 on 11/27/81.

B. Description of corner evidence found and/or method applied in restoring or reestablishing corner:

Corner research on file with Ontonagon County records.

Recovered the monument as described and the bearing trees as follows:

- 10" Cedar N.43 W. 6.95'
- 13" Red Maple S.33 W. 16.56'
- 16" Yellow Birch S.61 E. 38.98'
- 6' Steel sign rail N.25 W. 1.67'


No evidence remains from the original corner or bearing trees.

C. Description of monument for corner and accessories established to perpetuate locating the position of the corner:

New bearing tree referenced:

- 16" Hemlock N.53 E. 57.17'

BEER GROUP APPROVED
Carl W. Applekamp
 COUNTY RECORDER
 5-13-98

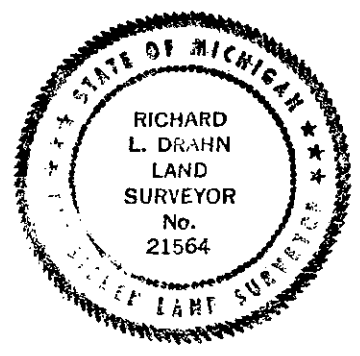

Signed by Richard L. Drahn Date May 4, 1998

Surveyor's Michigan License No. 21564