

DEC 16 1996

COMMISSION

JUDITH D. ROEHM
Ontonagon County
LC 4/120 JEM Fee: 9.00
07/11/96 09:07
Page 1 of 1

LAND CORNER RECORDATION CERTIFICATE
Filing Requirement of Act 74, Mich. P.A. 1970

For corners in

| Ontonagon (County) | Located In: | Corner Code ## |
|------------------------------------|---------------------------|----------------|
| 1. Public Land Survey | T <u>48N</u> R <u>43W</u> | <u>D-5</u> ✓ |
| | T _____ R _____ | _____ |
| | T _____ R _____ | _____ |
| | T _____ R _____ | _____ |
| 2. Property Controlling in Section | S _____ T _____ R _____ | _____ |
| | S _____ T _____ R _____ | _____ |
| 3. Miscellaneous Property in Sec. | S _____ T _____ R _____ | _____ |
| | S _____ T _____ R _____ | _____ |

Register of Deeds Stamp & File Number

4. Lot No. _____, Recorded Plat _____
5. Private Claims _____

1/4 Corner 8 & 17; T.48 n., R.43 W.

Richard L. Drahn in a field survey on June 18, 1996, do hereby certify that under requirements of P.A. 74, Michigan P.A. of 1970, the corner points mentioned in lines 1 and 2 above were in conformance with regulations and rules therefore as required in the current manual of survey instructions of the United States Department of the Interior, Bureau of Land Management or by a decree of a Court of Law and/or that the corner points mentioned in lines 3, 4 and 5 above were in conformance with the rules of the Michigan Board of Land Surveyors or by a Decree of a Court of Law; established, re-established, monumented, re-monumented, recovered, found as expressed below:


NOTE: Not more than 4 corners, all in the same town and range, may be recorded on this certificate.

A. Description of original monument and accessories and/or subsequent restoration:

Corner established by Austin Burt on Aug. 28, 1848. Original B.T.s --- Ironwood 6" S.76 W. 15 links (9.90') --- Sugar 10" N.64 E. 23 links (15.18') --- Corner restored by Richard L. Drahn RLS 21564 on 2/2/79 from the remains of the Sugar B.T. and from a line tree west and a natural feature tie east. He set a 2" dia. iron pipe with a 3" stamped brass cap and the following new bearing objects: --- 9" (10") Sugar Maple S.78 E. (S.79 E.) 19.9' (19.85') --- 4" Sugar Maple (dead) S.10 E. (S.14 E.) 18.9' --- 7" (11") Sugar Maple N.65 W. (N.63 W.) 9.18' (9.12') --- 6' Metal sign post S.20 E. (S.19 W.) 2.65' (2.65') ---

B. Description of corner evidence found and/or method applied in restoring or reestablishing corner:

Corner recorded in Ontonagon County in Liber 1, Page 196 on 4/11/80.

Act 74 research form on file with Ontonagon County records.

Recovered the monument as described and the bearing trees as noted in parentheses above.


A large series of root holes is all that remains of the original Sugar bearing tree.

C. Description of monument for corner and accessories established to perpetuate locating the position of the corner:

Bearing tree referenced:

5" Sugar Maple N.13 W. 29.35'

PEER GROUP APPROVED
Carl W. Applekamp
COUNTY REPRESENTATIVE
07-08-96

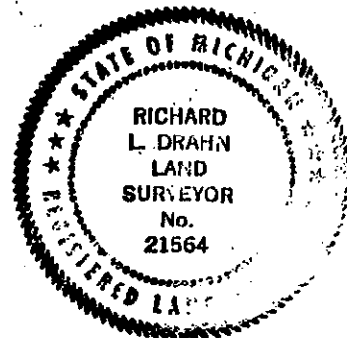

Signed by Richard L. Drahn Date June 20, 1996

Surveyor's Michigan License No. 21564