

DEC 16 1996

COMMISSION

JUDITH D. ROEHM  
Ontonagon County  
LC 4/110 JEM Feet 9.00  
07/11/96 08:54  
Page 1 of 1


LAND CORNER RECORDATION CERTIFICATE  
Filing Requirement of Act 74, Mich. P.A. 1970

For corners in

Ontonagon (County)	Located In:	Corner Code #
1. Public Land Survey	T 48N R 43W	F-3
	T _____ R _____	_____
	T _____ R _____	_____
	T _____ R _____	_____
2. Property Controlling in Section	S _____ T _____ R _____	_____
	S _____ T _____ R _____	_____
3. Miscellaneous Property in Sec.	S _____ T _____ R _____	_____
	S _____ T _____ R _____	_____
4. Lot No. _____, Recorded Plat _____		
5. Private Claims _____		

Register of Deeds Stamp & File Number

1/4 Corner 4 & 9; T.48 N., R.43 W.

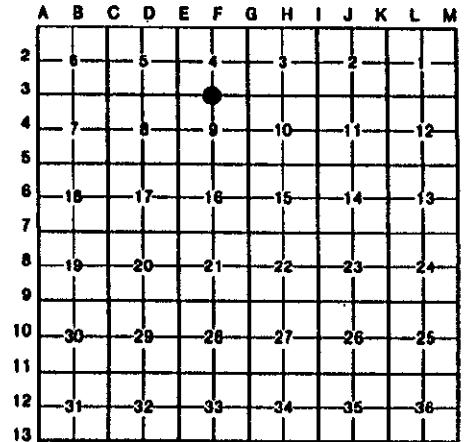

I, Richard L. Drahn in a field survey on June 18, 19 96, do hereby certify that under requirements of P.A. 74, Michigan P.A. of 1970, the corner points mentioned in lines 1 and 2 above were in conformance with regulations and rules therefore as required in the current manual of survey instructions of the United States Department of the Interior, Bureau of Land Management or by a decree of a Court of Law and/or that the corner points mentioned in lines 3, 4 and 5 above were in conformance with the rules of the Michigan Board of Land Surveyors or by a Decree of a Court of Law; established, re-established, monumented, re-monumented, recovered, found as expressed below:

NOTE: Not more than 4 corners, all in the same town and range, may be recorded on this certificate.

A. Description of original monument and accessories and/or subsequent restoration:

Corner established by Austin Burt on Aug. 26, 1848. Original B.T.s --- Spruce 10" S.77 W. 20 links (13.20') --- Cedar 7" N33 1/2 E. 19 links (12.54') --- Corner restored by Donald D. Lappala, RLS 12585 on 6/16/70 from the remains of the two original B.T.s (one still scribed). he set a 2 1/2" dia. iron pipe with a 3" stamped brass cap and the following new bearing trees: --- 5" (8") Cedar N. 57 W. 44.2' (43.87') --- 9" Cedar (now dead and down) S.33 E. 28.8' --- 7" (10") Cedar S.22 W (S.24 W.) 45.7' (45.90') --- Corner recorded in Ontonagon County in USFS Liber, Page E-11 on 9/14/72.

B. Description of corner evidence found and/or method applied in restoring or reestablishing corner:

Act 74 research form on file with Ontonagon County records.

Recovered the monument as described and the bearing trees as noted in parentheses above. No evidence remains of the original bearing trees.

PEER GROUP APPROVED  
Paul W Applekamp  
COUNTY REPRESENTATIVE  
07-08-96

C. Description of monument for corner and accessories established to perpetuate locating the position of the corner:

Bearing objects referenced:

4" X 4" Cedar sign post	S.33 E.	3.05'
6' Steel sign rail	N.77 W.	2.35'
4" Cedar	S.75 E.	6.00'



Signed by Richard L. Drahn Date June 20, 1996

Surveyor's Michigan License No. 21564