

**SURVEY &
REMONUMENTATION**

APR 29 1996

COMMISSION

LAND CORNER RECORDATION CERTIFICATE
Filing Requirement of Act 74, Mich. P.A. 1970

JUDITH D. ROEHN 10/26/95
Ontonagon County 14:10
LC 3/373 MEL Fee: 9.00
Page 1 of 1

For corners in ONTONAGON Located In: _____ Corner Code # _____
(County)


1. Public Land Survey T 48 R 43 I-5
T _____ R _____
T _____ R _____
T _____ R _____

2. Property Controlling S _____ T _____ R _____
in Section S _____ T _____ R _____

3. Miscellaneous S _____ T _____ R _____
Property in Section S _____ T _____ R _____

4. Lot No. _____, Recorded Plat _____

5. Private Claims _____

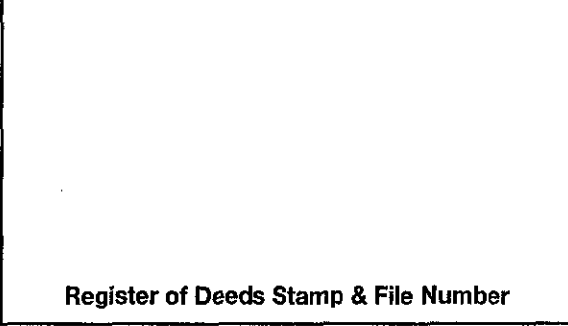

A	B	C	D	E	F	G	H	I	J	K	L	M
2	6	5	4	3	2	1						
3												
4	7	8	9	10	11	12						
5												
6	13	17	16	15	14	13						
7												
8	19	20	21	22	23	24						
9												
10	30	29	28	27	26	25						
11												
12	31	32	33	34	35	36						
13												

Section Corner common to 10, 11, 14 & 15, T48N R43W.

I, Earl W. Applekamp, in a field survey on August 31, 19 95, do hereby certify that under requirements of P.A. 74, Michigan P.A. of 1970, the corner points mentioned in lines 1 and 2 above were in conformance with regulations and rules therefore as required in the current manual of survey instructions of the United States Department of the Interior, Bureau of Land Management or by a decree of a Court of Law and/or that the corner points mentioned in lines 3, 4 and 5 above were in conformance with the rules of the Michigan Board of Professional Surveyors or by a Decree of a Court of Law; established, re-established, monumented, re-monumented, recovered, found as expressed below:

NOTE: Not more than 4 corners, all in the same town and range, may be recorded on this certificate.

A. Description of original monument and accessories and/or subsequent restoration:

Original corner established by Austin Burt, U.S. Deputy Surveyor, August 1848. Set Maple Post.

ORIGINAL BEARING TREES:

Spruce 14" S57°W 15 links (9.90 feet)
Maple 10" N55°E 3 links (1.98 feet)

B. Description of corner evidence found and/or method applied in restoring or reestablishing corner:

At the corner position I found a monument marking the position. This monument was set by Edward Kazianka and recorded August 9, 1976, in Liber 1 L.C., page 49. The monument was the same as described in the Act 74 form. The location was in agreement in distance to a recorded 1/4 Corner West and the recorded 1/4, and Section Corner to the East. I accepted the monument and updated the bearing trees and accessories as described in "C" below.

Research on file with County Remonumentation Program Representative.

PEER GROUP APPROVED
Earl W. Applekamp 10-18-95
COUNTY REPRESENTATIVE

C. Description of monument for corner and accessories established to perpetuate locating the position of the corner:

At the corner position stands a 1" diameter x 36" iron pipe with a four inch aluminum cap stamped as follows: Kimberly Clark Corp., T48N R43W, S.10, S.11, S.14, S.15, RLS 14765, 7-28-76. I established the following new bearing trees and reference objects:

5" Maple N47°W 26.23 feet - 7" Maple S15°E 17.02 feet
13" Cedar N69°E 34.73 feet - Steel Sign Post, North 1.39 feet



Signed by Earl W. Applekamp
Surveyor's Michigan License No. 17610

Date October 04, 1995