

SURVEY & REMONUMENTATION

APR 29 1995

COMMISSION

JUDITH D. ROEHL 10/26/95
 Ontonagon County 14:11
 LC 3/377 MEL Fee: 9.00
 Page 1 of 1

LAND CORNER RECORDATION CERTIFICATE
 Filing Requirement of Act 74, Mich. P.A. 1970

For corners in ONTONAGON Located In: _____ Corner Code # _____
 (County)

1. Public Land Survey	T 48 R 42	A-1
	T 48 R 43	M-1 ✓
	T 49 R 42	A-13
	T 49 R 43	M-13
2. Property Controlling in Section	S _____ T _____ R _____	_____
	S _____ T _____ R _____	_____
3. Miscellaneous Property in Section	S _____ T _____ R _____	_____
	S _____ T _____ R _____	_____

Register of Deeds Stamp & File Number

4. Lot No. _____, Recorded Plat _____
 5. Private Claims _____

Section Corner common to Sections 1, 6, 31, & 36, T48N R42W, T48N R43W, T49N R42W & T49N R43W.

I, Earl W. Applekamp, in a field survey on August 2, 1995, do hereby certify that under requirements of P.A. 74, Michigan P.A. of 1970, the corner points mentioned in lines 1 and 2 above were in conformance with regulations and rules therefore as required in the current manual of survey instructions of the United States Department of the Interior, Bureau of Land Management or by a decree of a Court of Law and/or that the corner points mentioned in lines 3, 4 and 5 above were in conformance with the rules of the Michigan Board of Professional Surveyors or by a Decree of a Court of Law; established, re-established, monumented, re-monumented, recovered, found as expressed below:

NOTE: Not more than 4 corners, all in the same town and range, may be recorded on this certificate.

A. Description of original monument and accessories and/or subsequent restoration:

Original Corner established by William A. Burt, U.S. Deputy Surveyor, August 14, 1848. Set Sugar Post.

ORIGINAL BEARING TREES:

Sugar 16" S40°E 11 links (7.26 feet)
 Sugar 12" N63°W 54 links (35.64 feet)

B. Description of corner evidence found and/or method applied in restoring or reestablishing corner:

No original evidence of post or bearing trees were found. A stream call on the original notes 640 feet North of corner, agrees with the location of the re-established corner. The corner was re-established at the latitude of the Section Corner 1 mile East and a 1/4 Corner 1/2 mile West. Departure of the corner was set at a proportional distance using the same two corners. Total distance differed by 15 feet compared to original notes. I established the monument described in "C" below.


Research on file with County Remonumentation Program Representative.

PEER GROUP APPROVED 10-18-95
Earl W. Applekamp
 COUNTY REPRESENTATIVE

C. Description of monument for corner and accessories established to perpetuate locating the position of the corner:

At the corner position I set a 2 1/2"x30" aluminum pipe with a 3/4" cap stamped to read: T48N R42W, T48N R43W, T49N R42W, T49N R43W, S1, S6, S31, S36, 1995 P.S. 17610. I established the following bearing trees and steel post.

4" Ironwood S40°W 15.00 feet - 6" Maple S71°E 25.35 feet
 10" Oak N53°E 41.95 feet - Steel Sign Post North 1.60 feet

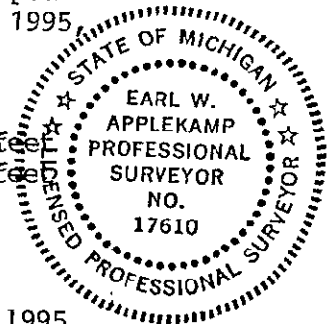

Signed by Earl W. Applekamp
 Surveyor's Michigan License No. 17610

Date September 21, 1995