

**LAND CORNER RECORDATION CERTIFICATE**  
**Filing Requirement of Act 74, Mich. P.A. 1970**

For corners in

Ontonagon (County)		Located In:		Corner Code #/
1. Public Land Survey	Sec. 6	T 47N	R 42W	A-1 GoG. Co.
	Sec. 1	T 47N	R 43W	M-1 GoG. Co.
	Sec. 31	T 48N	R 42W	A-13
	Sec. 36	T 48N	R 43W	M-13 ✓
2. Property Controlling in Section	S _____	T _____	R _____	Seq. 1
3. Miscellaneous Property in Sec.	S _____	T _____	R _____	

Register of Deeds Stamp & File Number

4. Lot No. \_\_\_\_\_, Recorded Plat \_\_\_\_\_  
 5. Private Claims \_\_\_\_\_  
 Section corner to Sections 1, 6, 31 & 36, T48-47N, R43-42W

	B	C	D	E	F	G	H	I	J	K	L
2	6	5	4	3	2	1					
3											
4	7	8	9	10	11	12					
5											
6	18	17	16	15	14	13					
7											
8	19	20	21	22	23	24					
9											
10	30	29	28	27	26	25					
11											
12	31	32	33	34	35	36					

I, John R. Garske, in a field survey on October 19, 1995, do hereby certify that under requirements of P.A. 74, Michigan P.A. of 1970, the corner points mentioned in lines 1 and 2 above were in conformance with regulations and rules therefore as required in the current manual of survey instructions of the United States Department of the Interior, Bureau of Land Management or by a decree of a Court of Law and/or that the corner points mentioned in lines 3, 4 and 5 above were in conformance with the rules of the Michigan Board of Land Surveyors or by a Decree of a Court of Law; established, re-established, monumented, re-monumented, recovered, found as expressed below:

**NOTE: Not more than 4 corners, all in the same town and range, may be recorded on this certificate.**

A. Description of original monument and accessories and/or subsequent restoration:

- Original survey by William Burt, U.S.D.S. on August 10, 1847. Set wood post from which a 9" B. Ash - N33°W - 12 links; 9" Elm - S14°E - 42 links.
- Corner was recorded on March 4, 1975, by Don Lappala, RLS 12585, who set a brass capped 2 1/2" diameter iron pipe from which he established a: 7" Y. Birch - N64°W - 31.0 feet; 12" Elm - S23°E - 29.9 feet; 7" B. Ash - N33°E - 16.8 feet.

Recorded in Liber I, page 290 of L.C.R.C.'s.

B. Description of corner evidence found and/or method applied in restoring or reestablishing corner:

I found a 3" diameter iron pipe with a 3" diameter brass cap 24" above ground set by Lappala in 1974. Also found bearing trees set by Lappala as described above. The 12" elm B.T. and 7" Y. birch B.T. are now dead. Established new accessories as noted below.

P.A. 74 research on file with County Representative's office.


PEER GROUP APPROVED

*Paul Koptanup*  
 COUNTY REPRESENTATIVE 11-06-95

C. Description of monument for corner and accessories established to perpetuate locating the position of the corner:

I used Lappala's existing monument which reads T48-47N, R43-42W, S-31; S-36; S-1; S-6; 1974; RLS 12585. I established the following bearing trees and reference objects:

- 4" x 4" wood post - Due North - 2.90 feet (existing)
- 12" Ash - N39°E - 16.68 feet (existing)
- 4" Maple - N80°W - 4.17 feet
- 6" Maple - S04°E - 16.47 feet
- 1 1/4" drill steel - S28°E - 11.35 feet (found)

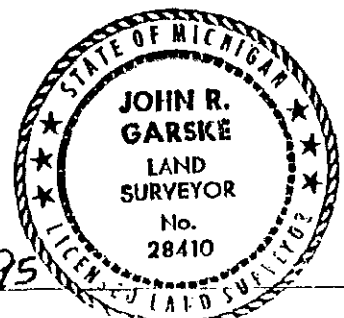

Signed by John R. Garske Date 11-6-95  
 Surveyor's Michigan License No. 28410