

**SURVEY & REMONUMENTATION**

DEC 16 1995

**COMMISSION**

JUDITH D. ROEHM  
 Ontonagon County  
 LC 4/ 28 JEM Fee: 9.00  
 Page 1 of 1

**LAND CORNER RECORDATION CERTIFICATE**  
 Filing Requirement of Act 74, Mich. P.A. 1970

For corners in

<u>Ontonagon</u> (County)	Located In:	Corner Code #
1. Public Land Survey	T <u>49N</u> R <u>38</u> W.	<u>F-1</u> ✓
	T _____ R _____	_____
	T <u>50N</u> R <u>38</u> W.	<u>F-13</u>
	T _____ R _____	_____
2. Property Controlling in Section	S _____ T _____ R _____	_____
	S _____ T _____ R _____	_____
3. Miscellaneous Property in Sec.	S _____ T _____ R _____	_____
	S _____ T _____ R _____	_____
4. Lot No. _____, Recorded Plat _____		
5. Private Claims _____		

Register of Deeds Stamp & File Number

Quarter corner 4 & 33; T.49-50 N., R.38 W.

I, Richard L. Drahn in a field survey on July 18, 19 95, do hereby certify that under requirements of P.A. 74, Michigan P.A. of 1970, the corner points mentioned in lines 1 and 2 above were in conformance with regulations and rules therefore as required in the current manual of survey instructions of the United States Department of the Interior, Bureau of Land Management or by a decree of a Court of Law and/or that the corner points mentioned in lines 3, 4 and 5 above were in conformance with the rules of the Michigan Board of Land Surveyors or by a Decree of a Court of Law; established, re-established, monumented, re-monumented, recovered, found as expressed below:

	A	B	C	D	E	F	G	H	I	J	K	L	M
2	6		5		4		3		2		1		
3													
4	7		8		9		10		11		12		
6													
6	18		17		16		15		14		13		
7													
8	19		20		21		22		23		24		
9													
10	30		29		28		27		26		25		
11													
12	31		32		33		34		35		36		
13													

**NOTE: Not more than 4 corners, all in the same town and range, may be recorded on this certificate.**

A. Description of original monument and accessories and/or subsequent restoration:

Original corner established by Austin Burt, Deputy Surveyor on June 24, 1847.  
 Original bearing trees:

Cedar	12"	N.28 E.	42 links	(27.72 feet)
Cedar	12"	N.32 W.	27 links	(17.82 feet)

Corner research on file with Ontonagon County records. (6/6/95)

B. Description of corner evidence found and/or method applied in restoring or reestablishing corner:

No evidence of original corner or bearing trees found. Corner re-established on line between and proportionate distance from, the section corner 1/2 mile east and the quarter corner 1 mile west.

No evidence of subsequent corner restoration found.


PEER GROUP APPROVED

*Earl W. Applbaum*  
 COUNTY REPRESENTATIVE

C. Description of monument for corner and accessories established to perpetuate locating the position of the corner:

At the corner position I set a standard 2 1/2" x 30" long aluminum monument with a 3 1/4" aluminum cap, stamped to read: T.49-50 N., R.38 W.; 1/4; S-33, S-4; 1995; R.L.S. 21564. From which I established the following new blazed and scribed bearing trees:

13"	Sugar Maple	N.17 W.	27.53 feet
12"	Hemlock	N.65 E.	26.69 feet
13"	Sugar Maple	S.16 E.	12.90 feet
6'	Steel rail	S.07 E.	1.52 feet

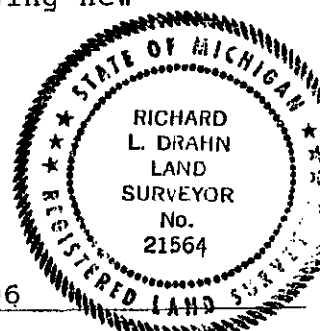

Signed by Richard L. Drahn

Date February 26, 1996

Surveyor's Michigan License No. 21564