

APR 29 1995

**COMMISSION**

**LAND CORNER RECORDATION CERTIFICATE**  
 Filing Requirement of Act 74, Mich. P.A. 1970

05/09/95  
 13:51  
 Fee: .00  
 Page 1 of 1

For corners in

Ontonagon  
 (County)

Located In:

Corner Code #


- |                                    |                           |            |
|------------------------------------|---------------------------|------------|
| 1. Public Land Survey              | T <u>49N</u> R <u>38W</u> | <u>J-3</u> |
|                                    | T _____ R _____           | _____      |
|                                    | T _____ R _____           | _____      |
|                                    | T _____ R _____           | _____      |
| 2. Property Controlling in Section | S _____ T _____ R _____   | _____      |
|                                    | S _____ T _____ R _____   | _____      |
| 3. Miscellaneous Property in Sec.  | S _____ T _____ R _____   | _____      |
|                                    | S _____ T _____ R _____   | _____      |

**Register of Deeds Stamp & File Number**

4. Lot No. \_\_\_\_\_, Recorded Plat \_\_\_\_\_  
 5. Private Claims \_\_\_\_\_

1/4 Corner Sections 2 & 11; T.49N., R.38W.

I, Richard L. Drahn, in a field survey on May 15, 19 94, do hereby certify that under requirements of P.A. 74, Michigan P.A. of 1970, the corner points mentioned in lines 1 and 2 above were in conformance with regulations and rules therefore as required in the current manual of survey instructions of the United States Department of the Interior, Bureau of Land Management or by a decree of a Court of Law and/or that the corner points mentioned in lines 3, 4 and 5 above were in conformance with the rules of the Michigan Board of Land Surveyors or by a Decree of a Court of Law; established, re-established, monumented, re-monumented, recovered, found as expressed below:

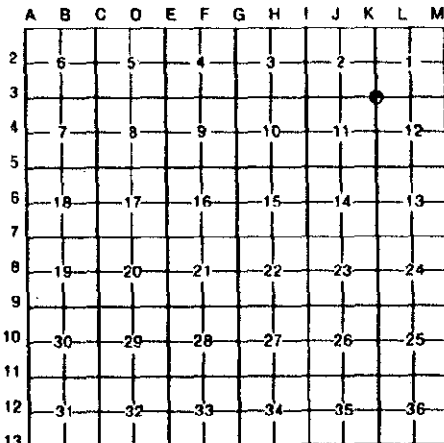

**NOTE: Not more than 4 corners, all in the same town and range, may be recorded on this certificate.**

A. Description of original monument and accessories and/or subsequent restoration:  
 Corner established by Artimus Curtis, U.S. Deputy Surveyor, on June 23, 1851. Original bearing trees:

Sugar	15	N.54W.	36 links	(23.76 feet)
Hemlock	6	S.41E.	12 links	(7.92 feet)

B. Description of corner evidence found and/or method applied in restoring or reestablishing corner:  
 No evidence of the original survey remains. Corner position re-established on line between and equal distance from the southeast and southwest section corners of Section 2; T.49N., R.38W.

**ONTONAGON COUNTY**  
**FEEL APPROVED**

*Earl W. Leppikang*  
*Ont Co Reg*  
*May 07, 1995*

C. Description of monument for corner and accessories established to perpetuate locating the position of the corner:  
 At the corner position I set a 2 1/2" diameter by 30" long aluminum monument with a 3 1/4" aluminum cap with magnet stamped to read: T.49N., R.38W.; 1/4; S-2, S-11; 1994; R.L.S. 21564 from which I established the following new blazed and scribed bearing trees and/or objects:

12"	White Spruce	N.22W.	22.65 feet
6"	Sugar Maple	N.75E.	3.43 feet
8"	Sugar Maple	S.30E.	4.25 feet
6'	Steel Rail	N.20E.	1.1 feet



Signed by Richard L. Drahn Date February 6, 1995

Surveyor's Michigan License No. 21564

USFS #E-19