

SURVEY & REMONUMENTATION

APR 29 1996


COMMISSION

JUDITH D. ROEHM
 Ontonagon County
 LC 3/398 JEM Fee: 9.00
 10/26/95 08:09
 Page 1 of 1

LAND CORNER RECORDATION CERTIFICATE
 Filing Requirement of Act 74, Mich. P.A. 1970

For corners in ONTONAGON Located In: _____ Corner Code # _____
 (County)

1. Public Land Survey	T <u>49N</u>	R <u>41W</u>	<u>C-12</u>
	T _____	R _____	_____
	T _____	R _____	_____
	T _____	R _____	_____
2. Property Controlling in Section	S _____	T _____	R _____
	S _____	T _____	R _____
3. Miscellaneous Property in Section	S _____	T _____	R _____
	S _____	T _____	R _____

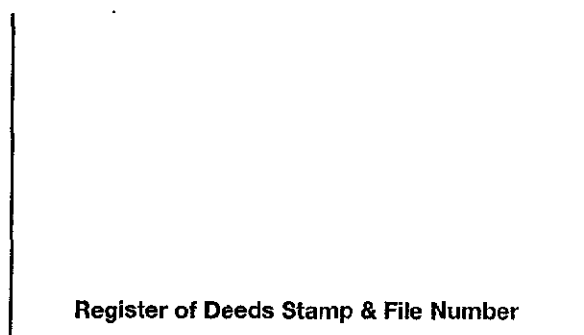

4. Lot No. _____, Recorded Plat _____
 5. Private Claims _____

$\frac{1}{2}$ Corner common to Sections 31 & 32, T49N R41W

I, Earl W. Applekamp, in a field survey on July 22, 19 95, do hereby certify that under requirements of P.A. 74, Michigan P.A. of 1970, the corner points mentioned in lines 1 and 2 above were in conformance with regulations and rules therefore as required in the current manual of survey instructions of the United States Department of the Interior, Bureau of Land Management or by a decree of a Court of Law and/or that the corner points mentioned in lines 3, 4 and 5 above were in conformance with the rules of the Michigan Board of Professional Surveyors or by a Decree of a Court of Law; established, re-established, monumented, re-monumented, recovered, found as expressed below:

A	B	C	D	E	F	G	H	I	J	K	L	M
2	6	5	4	3	2							
3												
4	7	8	9	10	11	12						
5												
6	18	17	16	15	14	13						
7												
8	19	20	21	22	23	24						
9												
10	30	29	28	27	26	25						
11												
12	31	32	33	34	35	36						
13												

NOTE: Not more than 4 corners, all in the same town and range, may be recorded on this certificate.

A. Description of original monument and accessories and/or subsequent restoration:

Original corner established by S.W. Higgins, U.S. Deputy Surveyor, summer 1847. Set Post.


ORIGINAL BEARING TREES:

Lynn 14"	S80°W	24 Links (15.84 feet)
Sugar 12"	N64°E	25 Links (16.50 feet)

B. Description of corner evidence found and/or method applied in restoring or reestablishing corner:

No evidence of the original corner was found. Corner was re-established by single proportionate measurement between the section corner to the North & South. I set a monument described in "C" below. This corner is one of 29 corners in 6 Sections remonumented under the County Remonumentation Program. Research is on file with the County Remonumentation Program Representative.

PEER GROUP APPROVED
Earl W. Applekamp
COUNTY REPRESENTATIVE 10-18-95

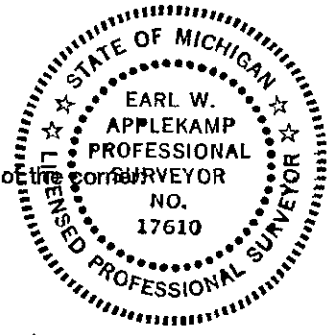

C. Description of monument for corner and accessories established to perpetuate locating the position of the corner:

At the corner position I set a 2 $\frac{1}{2}$ "x30" long aluminum pipe with a 3 $\frac{1}{4}$ " cap stamped to read: COUNTY REMONUMENTATION, $\frac{1}{4}$, S31, S32, T49N R41W, 1995, P.S. 17610. I established the following bearing trees and reference objects:

6" Maple	S64°W	42.06 feet	-	4" Maple West	14.46 feet
7" Maple	S24°E	22.32 feet	-	Steel Sign Post North	1.29 feet

Signed by Earl W. Applekamp Date July 24, 1995
 Surveyor's Michigan License No. 17610