

SURVEY & REMONUMENTATION

APR 29 1996

JUDITH D. ROEHM
Ontonagon County
LC 3/ 298 JEM

3/09/95
14:07
Fee: 9.00
Page 1 of 1

COMMISSION LAND CORNER RECORDATION CERTIFICATE

Filing Requirement of Act 74, Mich. P.A. 1970

For corners in ONTONAGON Located in: Corner Code #
(County)

JUDITH D. ROEHM
Ontonagon County
LC 3/ 298 JEM
Fee: 9.00
Page 1 of 1

1. Public Land Survey	T 48 R 41	C-1
	T 49 R 41	C-13 ✓
	T _____ R _____	_____
	T _____ R _____	_____
2. Property Controlling in Section	S _____ T _____ R _____	_____
	S _____ T _____ R _____	_____
3. Miscellaneous Property in Section	S _____ T _____ R _____	_____
	S _____ T _____ R _____	_____

Register of Deeds Stamp & File Number

4. Lot No. _____, Recorded Plat _____
5. Private Claims _____

Section Corner common to Section 5 & 6, T48N R41W & Sections 31 & 32, T49N R41W

I, Earl W. Applekamp, in a field survey on June 27, 1995, do hereby certify that under requirements of P.A. 74, Michigan P.A. of 1970, the corner points mentioned in lines 1 and 2 above were in conformance with regulations and rules therefore as required in the current manual of survey instructions of the United States Department of the Interior, Bureau of Land Management or by a decree of a Court of Law and/or that the corner points mentioned in lines 3, 4 and 5 above were in conformance with the rules of the Michigan Board of Professional Surveyors or by a Decree of a Court of Law; established, re-established, monumented, re-monumented, recovered, found as expressed below:

NOTE: Not more than 4 corners, all in the same town and range, may be recorded on this certificate.

	A	B	C	D	E	F	G	H	I	J	K	L	M
2	6	5	4	3	2	1							
3													
4	7	8	9	10	11	12							
5													
6	18	17	16	15	14	13							
7													
8	19	20	21	22	23	24							
9													
10	30	29	28	27	26	25							
11													
12	31	32	33	34	35	36							
13													

A. Description of original monument and accessories and/or subsequent restoration:

Original corner established by William A. Burt, U.S. Deputy Surveyor in July 1847. Set Cedar Post.


BEARING TREES:

Sugar Maple 5" N25°W 15 Links (9.90 feet)
Sugar Maple 10" N52°E 13 Links (8.58 feet)

B. Description of corner evidence found and/or method applied in restoring or reestablishing corner:

At the corner location there is a dirt road running N-S. A fence line runs East & West at this point. An original call to a stream 3.50 Chains South is in agreement with the above features. There was no object at the actual corner location. I set a monument described below, 3" below grade of a dirt road. This corner is one of 29 corners in 6 Sections remonumented under the County Remonumentation Program. Research on file with the Ontonagon County Remonumentation Program Representative.

PEER GROUP APPROVED
Earl W. Applekamp 8-08-95
COUNTY REPRESENTATIVE

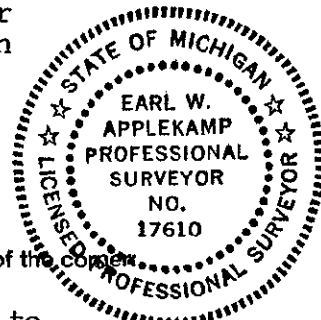

C. Description of monument for corner and accessories established to perpetuate locating the position of the corner:

At the corner location I set a 2 1/2" aluminum pipe with a 3 1/4" cap stamped to read: COUNTY REMONUMENTATION, Section 5, 6, T48N R41W, Section 31, 32, T49N R41W, 1995, P.S. 17610. I tied the corner to the following bearing trees and reference objects:

Corner Fence Post N71°W 35.68 feet 5" Aspen N33°E 47.15 feet
7" Aspen S46°W 74.70 feet Steel Sign Post East 19.50 feet

Signed by Earl W. Applekamp Date July 12, 1995
Surveyor's Michigan License No. 17610