

APR 29 1996

COMMISSION

JUDITH D. ROEHM
Ontonagon County
LC 3/287 JEM Fee: 9.00
08/09/95
13:35
Page 1 of 1

LAND CORNER RECORDATION CERTIFICATE
Filing Requirement of Act 74, Mich. P.A. 1970

For corners in ONTONAGON Located In: _____ Corner Code # _____
(County)


- 1. Public Land Survey T ~~48~~ R 41
T 49 R 41 D-13
- 2. Property Controlling S _____ T _____ R _____
in Section S _____ T _____ R _____
- 3. Miscellaneous S _____ T _____ R _____
Property in Section S _____ T _____ R _____

Register of Deeds Stamp & File Number

- 4. Lot No. _____, Recorded Plat _____
- 5. Private Claims _____

$\frac{1}{4}$ Corner common to S5 & S32, T48N & T49N, R41W

I, Earl W. Applekamp, in a field survey on July 01, 19 95, do hereby certify that under requirements of P.A. 74, Michigan P.A. of 1970, the corner points mentioned in lines 1 and 2 above were in conformance with regulations and rules therefore as required in the current manual of survey instructions of the United States Department of the Interior, Bureau of Land Management or by a decree of a Court of Law and/or that the corner points mentioned in lines 3, 4 and 5 above were in conformance with the rules of the Michigan Board of Professional Surveyors or by a Decree of a Court of Law; established, re-established, monumented, re-monumented, recovered, found as expressed below:

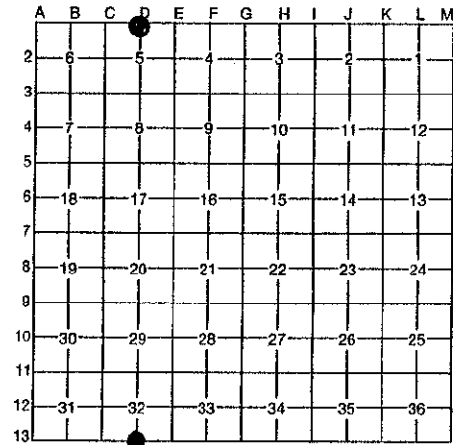

NOTE: Not more than 4 corners, all in the same town and range, may be recorded on this certificate.

A. Description of original monument and accessories and/or subsequent restoration:

Original corner established by William A. Burt, U.S. Deputy Surveyor, July 1857. Set Cedar Post.

White Pine	16"	N52°E	32 Links (21.12 feet)
Hemlock	12"	N13°W	20 Links (13.20 feet)

B. Description of corner evidence found and/or method applied in restoring or reestablishing corner:

No original evidence was found. Corner was established by single proportionate measurement between the Section corner East & West. I monumented the corner as described in "C" below. This corner is one of 29 corners in 6 Sections remonumented under the County Remonumentation Program. Research is on file with the Ontonagon County Remonumentation Program Representative.

PEER GROUP APPROVED

Earl W. Applekamp 8-08-95
COUNTY REPRESENTATIVE

C. Description of monument for corner and accessories established to perpetuate locating the position of the corner:

At the corner position I set a 2 $\frac{1}{4}$ "x30" aluminum pipe with a 3 $\frac{1}{4}$ " cap stamped to read as follows: COUNTY REMONUMENTATION, $\frac{1}{4}$, S5, S32, T48N, T49N, R41W, 1995, P.S. 17610. I established the following bearing trees and reference objects:

7" White Pine	S85°W	48.27 feet	5" Aspen	S83°E	32.02 feet
6" Aspen	S01°W	31.36 feet	Steel Sign Post	North	1.61 feet



Signed by Earl W. Applekamp Date July 12, 1995
Surveyor's Michigan License No. 17610