

SURVEY & REMONUMENTATION

APR 29 1996

JUDITH D. ROEHM
 Ontonagon County
 LC 3/370 MEL Fee: 9.00
 10/26/95 14:09
 Page 1 of 1

LAND CORNER RECORDATION CERTIFICATE
 Filing Requirement of Act 74, Mich. P.A. 1970

COMMISSION

For corners in ONTONAGON Located In: _____ Corner Code # _____
 (County)

- | | | |
|------------------------------------|-------------------------|-------------|
| 1. Public Land Survey | T <u>49</u> R <u>42</u> | <u>B-11</u> |
| | T _____ R _____ | _____ |
| | T _____ R _____ | _____ |
| | T _____ R _____ | _____ |
| 2. Property Controlling in Section | S _____ T _____ R _____ | _____ |
| | S _____ T _____ R _____ | _____ |
| 3. Miscellaneous | S _____ T _____ R _____ | _____ |
| Property in Section | S _____ T _____ R _____ | _____ |

Register of Deeds Stamp & File Number

4. Lot No. _____, Recorded Plat _____
 5. Private Claims _____

$\frac{1}{4}$ Corner common to Sections 30 & 31, T49N R42W.

I, Earl W. Applekamp, in a field survey on August 30, 19 95, do hereby certify that under requirements of P.A. 74, Michigan P.A. of 1970, the corner points mentioned in lines 1 and 2 above were in conformance with regulations and rules therefore as required in the current manual of survey instructions of the United States Department of the Interior, Bureau of Land Management or by a decree of a Court of Law and/or that the corner points mentioned in lines 3, 4 and 5 above were in conformance with the rules of the Michigan Board of Professional Surveyors or by a Decree of a Court of Law; established, re-established, monumented, re-monumented, recovered, found as expressed below:

A	B	C	D	E	F	G	H	I	J	K	L	M
2	6		5		4		3		2			
3												
4	7		8		9		10		11		12	
5												
6	18		17		16		15		14		13	
7												
8	19		20		21		22		23		24	
9												
10	30		29		28		27		26		25	
11												
12	31		32		33		34		35		36	
13												

NOTE: Not more than 4 corners, all in the same town and range, may be recorded on this certificate.

A. Description of original monument and accessories and/or subsequent restoration:

Original corner established by William Burt, U.S. Deputy Surveyor August 1848. Set Sugar Post.

ORIGINAL BEARING TREES:

Hemlock 12"	N55°E	39 links	(25.74 feet)
Hemlock 16"	S72°W	23 links	(15.18 feet)

B. Description of corner evidence found and/or method applied in restoring or reestablishing corner:

No original evidence was found. Corner was re-established by single proportionate measurement between opposite section corners.

Research on file with County Remonumentation Program Representative.


PEER GROUP APPROVED 10-18-95

Earl W. Applekamp
 COUNTY REPRESENTATIVE

C. Description of monument for corner and accessories established to perpetuate locating the position of the corner:

At the corner position I set a $2\frac{1}{2}$ "x30" aluminum pipe with a $3\frac{1}{4}$ " cap stamped to read: T49N R42W, $\frac{1}{4}$, S.30, S.31, 1995, P.S. 17610. I established the following bearing trees and reference objects.

7" Maple	S71°W	17.89 feet	-	7" Yellow Birch	N04°E	53.64 feet
8" Ash	S52°E	39.00 feet	-	Steel Sign Post	South	1.32 feet

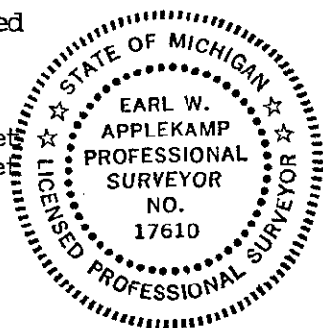

Signed by Earl W. Applekamp
 Surveyor's Michigan License No. 17610

Date October 03, 1995