

LAND CORNER RECORDATION CERTIFICATE
 Filing Requirement of Act 74, Mich. P.A. 1970

For corners in

_____	Located In:	Corner Code #
<u>ONTONAGON</u> (County)		
1. Public Land Survey	T <u>49N</u> R <u>42W</u>	<u>C-9</u>
	T _____ R _____	_____
	T _____ R _____	_____
	T _____ R _____	_____
2. Property Controlling in Section	S _____ T _____ R _____	_____
	S _____ T _____ R _____	_____
3. Miscellaneous Property in Sec.	S _____ T _____ R _____	_____
	S _____ T _____ R _____	_____


SURVEY & REMONUMENTATION

MAR 23 2000

SECTION

Register of Deeds Stamp & File Number

4. Lot No. _____, Recorded Plat _____
 5. Private Claims _____

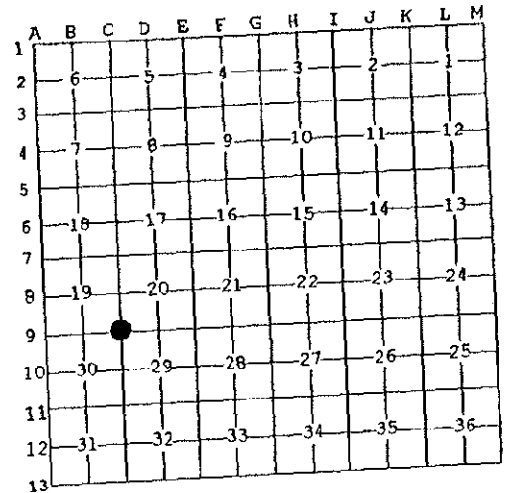

Section Corner common to Sections 19, 20, 29 & 30, T49N R42W.

I, Earl W. Applekamp, in a field survey on Oct. 31, 1999 do hereby state that under requirements of P.A. 74, Michigan P.A. of 1970, the corner points mentioned in lines 1 and 2 above were in conformance with regulations and rules therefore as required in the current manual of survey instructions of the United States Department of the Interior, Bureau of Land Management or by a decree of a Court of Law and/or that the corner points mentioned in lines 3, 4 and 5 above were in conformance with the rules of the Michigan Board of Land Surveyors or by a Decree of a Court of Law, established, re-established, monumented, recovered, found as expressed below:

NOTE: Not more than 2 corners, all in the same town and range, may be recorded on this certificate.

A. Description of original monument and accessories and/or subsequent restoration:

Original Corner established by William Burt, U.S. Deputy Surveyor, June 1848. Set Ironwood Post.

ORIGINAL BEARING TREES:

Hemlock	36"	N08°W	47 Links (31.02 feet)
Y. Birch	18"	S55°E	12 Links (7.92 feet)

DEED GROUP APPROVED
Earl W. Applekamp 11-09-99
 COUNTY REPRESENTATIVE

B. Description of corner evidence found and/or method applied in restoring or reestablishing corner:

No original evidence was found. There was a 4"x4" tag on a 20" Maple dated 1951 marked approximate corner 10 Links North. The Bessemer Forest Service confirmed this information. The SW $\frac{1}{4}$ of SW $\frac{1}{4}$, Section 20, has been farmed since the 1930'S. The fence posts are still standing and the fields are being mowed. In 1946 a major logging road to service White River Lumber Co. in Bergland was built and crossed through the Southwest Corner of Section 20. This would have destroyed the Y. Birch bearing tree. I accepted the intersection of the projection of the South & West fence lines as being the most logical position for the Corner.

Research on file with the Ontonagon County Remonumentation Program Representative.

C. Description of monument for corner and accessories established to perpetuate locating the position of the corner:

At the corner position I set a 2 $\frac{1}{2}$ "x30" split base aluminum pipe with a 3" cap stamped to read: County Remonumentation, T49N R42W, S19, S20, S29, S30, 1999, P.S. 17610. I established three bearing trees and a reference object.

Nail in 9" H. Maple	N62°W	55.12'	-	Nail in 10" H. Maple	S80°E	78.38'
Nail in 9" H. Maple	N05°W	67.85'	-	6' Steel Sign Post	South	0.43'



Signed by Earl W. Applekamp
 Surveyor's Michigan License No. 17610

Date November 8, 1999