

LAND CORNER RECORDATION CERTIFICATE
 Filing Requirement of Act 74, Mich. P.A. 1970

For corners in

<u>ONTONAGON</u> (County)	Located In:	Corner Code #
1. Public Land Survey	T49N R 42W	C-10
	T ___ R ___	_____
	T ___ R ___	_____
	T ___ R ___	_____
2. Property Controlling in Section	S ___ T ___ R ___	_____
	S ___ T ___ R ___	_____
3. Miscellaneous Property in Sec.	S ___ T ___ R ___	_____
	S ___ T ___ R ___	_____

SURVEY &
 REMONUMENTATION

MAR 23 2000

SECTION

Register of Deeds Stamp & File Number

4. Lot No. _____, Recorded Plat _____
 5. Private Claims _____

1/4 Corner common to Sections 29 & 30, T49N R42W.

I, Earl W. Applekamp, in a field survey on Nov. 11, 1999 do hereby state that under requirements of P.A. 74, Michigan P.A. of 1970, the corner points mentioned in lines 1 and 2 above were in conformance with regulations and rules therefore as required in the current manual of survey instructions of the United States Department of the Interior, Bureau of Land Management or by a decree of a Court of Law and/or that the corner points mentioned in lines 3, 4 and 5 above were in conformance with the rules of the Michigan Board of Land Surveyors or by a Decree of a Court of Law; established, re-established, monumented, recovered, found as expressed below:

NOTE: Not more than 2 corners, all in the same town and range, may be recorded on this certificate.

	A	B	C	D	E	F	G	H	I	J	K	L	M
1													
2		6		5		4		3		2		1	
3													
4		7		8		9		10		11		12	
5													
6		18		17		16		15		14		13	
7													
8		19		20		21		22		23		24	
9													
10		30		29		28		27		26		25	
11													
12		31		32		33		34		35		36	
13													

A. Description of original monument and accessories and/or subsequent restoration:

Original Corner established by William Burt, U.S. Deputy Surveyor, June 16, 1848. Set Maple Post.

ORIGINAL BEARING TREES:

Y. Birch 18" N70°E 2 Links (1.32 Feet)
 Hemlock 10" S40°W 47 Links (31.02 Feet)

PEER GROUP APPROVED
Earl W. Applekamp
 COUNTY REPRESENTATIVE
 11-30-99

B. Description of corner evidence found and/or method applied in restoring or reestablishing corner:


No original evidence was found. Original bearing trees would have been destroyed by construction of a road running South and West from the Corner position. I re-established the corner at single proportionate measure between opposite corners North and South and at the intersection of the two roads.

Research on file with the Ontonagon County Remonumentation Program Representative.

C. Description of monument for corner and accessories established to perpetuate locating the position of the corner:

At the Corner position I set a 2 1/2"X30" split base aluminum monument, flush with the dirt road, with a 3" cap stamped to read: County Remonumentation, T49N R42W, S29, S30, 1/4, 1999, P.S. 17610. I established three bearing trees and a reference object.

Nail in 7" Maple S73°W 59.95' - Nail in 10" Maple S59°E 31.85'
 Nail in 7" Hard Maple N21°E 72.57' - 6' Steel Sign Post, South 0.65'

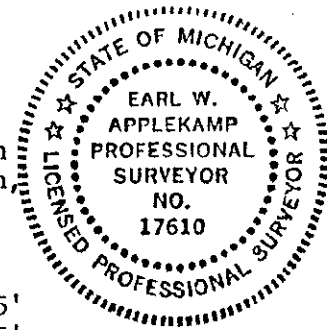

Signed by Earl W. Applekamp
 Surveyor's Michigan License No. 17610

Date November 19, 1999