

LAND CORNER RECORDATION CERTIFICATE
 Filing Requirement of Act 74, Mich. P.A. 1970

For corners in

ONTONAGON (County)	Located In:	Corner Code #
1. Public Land Survey	T 49N R 42W	D-7
	T ___ R ___	_____
	T ___ R ___	_____
	T ___ R ___	_____
2. Property Controlling in Section	S ___ T ___ R ___	_____
	S ___ T ___ R ___	_____
3. Miscellaneous Property in Sec.	S ___ T ___ R ___	_____
	S ___ T ___ R ___	_____

**SURVEY &
REMONUMENTATION**

MAR 23 2000


SECTION

Register of Deeds Stamp & File Number

4. Lot No. _____, Recorded Plat _____
 5. Private Claims _____

1/4 Corner common to Sections 17 & 20, T49N R42W.

I, Earl W. Applekamp, in a field survey on Nov. 18, 1999 do hereby state that under requirements of P.A. 74, Michigan P.A. of 1970, the corner points mentioned in lines 1 and 2 above were in conformance with regulations and rules therefore as required in the current manual of survey instructions of the United States Department of the Interior, Bureau of Land Management or by a decree of a Court of Law and for that the corner points mentioned in lines 3, 4 and 5 above were in conformance with the rules of the Michigan Board of Land Surveyors or by a Decree of a Court of Law; established, re-established, monumented, recovered, found as expressed below:

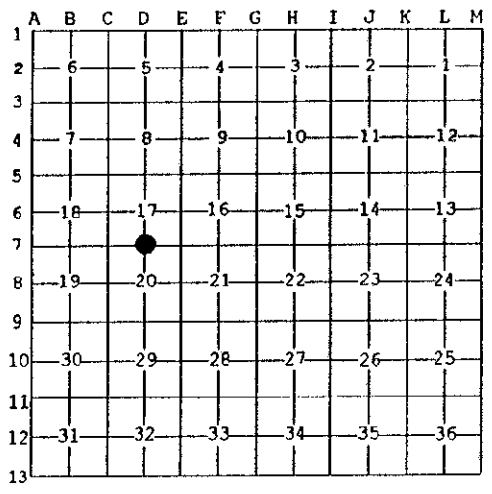

NOTE: Not more than 2 corners, all in the same town and range, may be recorded on this certificate.

A. Description of original monument and accessories and/or subsequent restoration:
 Original Corner established by William Burt, U.S. Deputy Surveyor, June 16, 1848.

ORIGINAL BEARING TREES:
 Sugar 12" S50°W 35 Links (23.10 Feet)
 Sugar 14" N65°E 7 Links (4.62 Feet)


Corner position was re-established by Richard L. Drahn, RLS 21564 on May 7, 1981 and recorded in Liber 2, Page 68, June 15, 1982. He re-established on line and equal distance between the recorded SE & SW Corners of Section 17.

B. Description of corner evidence found and/or method applied in restoring or reestablishing corner:
 At the corner position I found a 2"IDX30" long, split base aluminum monument with a 3 1/4" aluminum cap set by Richard Drahn in 1981. The cap was stamped, T49N R42W, 1/4, S17, S20, 1981, RLS 21564. The bearing trees established by Richard Drahn were all in good condition. They were 10" (14") Sugar Maple, N49°W, 16.82 Feet, 14" (16") Sugar Maple S20°E, 8.61 Feet. 12" (14") Sugar Maple S76°W, 33.19 Feet.

Research on file with the Ontonagon County Remonumentation Program Representative.

C. Description of monument for corner and accessories established to perpetuate locating the position of the corner:
 I accepted the corner re-established by Richard Drahn and added one new bearing tree, a nail in a 11" Sugar Maple, N24°W, 31.54 Feet. A 7' Metal Sign Post bear N50°E, 2.3 Feet.

PEER GROUP APPROVED
Earl W. Applekamp
 COUNTY SUPERVISOR
 11-30-99

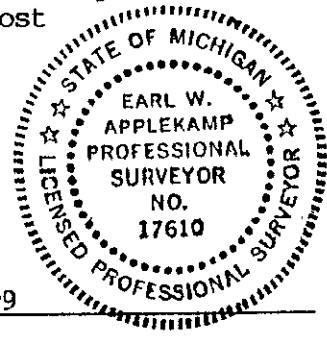

Signed by Earl W. Applekamp
 Surveyor's Michigan License No. 17610

Date November 20, 1999