

SURVEY & REMONUMENTATION

APR 29 1996

COMMISSION

JUDITH D. ROEHM
Ontonagon County
LC 3/285 JEM Fee: 9.00
07/19/95
10:31
Page 1 of 1

LAND CORNER RECORDATION CERTIFICATE
Filing Requirement of Act 74, Mich. P.A. 1970

For corners in

<u>Ontonagon</u> (County)	Located In:	Corner Code #:
1. Public Land Survey	T <u>50N</u> R <u>42W</u>	E-13
	T <u>49N</u> R <u>42W</u>	<u>(E-1)</u>
	T _____ R _____	_____
	T _____ R _____	_____
2. Property Controlling in Section	S _____ T _____ R _____	_____
	S _____ T _____ R _____	_____
3. Miscellaneous Property in Sec.	S _____ T _____ R _____	_____
	S _____ T _____ R _____	_____
4. Lot No. _____, Recorded Plat _____		
5. Private Claims _____		

Register of Deeds Stamp & File Number

Section Corner 32, 33, 4 & 5; T.49-50 N., R.42 W.

I, Richard L. Drahn in a field survey on June 8, 19 95, do hereby certify that under requirements of P.A. 74, Michigan P.A. of 1970, the corner points mentioned in lines 1 and 2 above were in conformance with regulations and rules therefore as required in the current manual of survey instructions of the United States Department of the Interior, Bureau of Land Management or by a decree of a Court of Law and/or that the corner points mentioned in lines 3, 4 and 5 above were in conformance with the rules of the Michigan Board of Land Surveyors or by a Decree of a Court of Law; established, re-established, monumented, re-monumented, recovered, found as expressed below:

A	B	C	D	E	F	G	H	I	J	K	L	M
2	6	5	4	3	2	1						
3												
4	7	8	9	10	11	12						
5												
6	18	17	16	15	14	13						
7												
8	19	20	21	22	23	24						
9												
10	30	29	28	27	26	25						
11												
12	31	32	33	34	35	36						
13												

NOTE: Not more than 4 corners, all in the same town and range, may be recorded on this certificate.

A. Description of original monument and accessories and/or subsequent restoration:
Corner established by William A. Burt on August 18, 1847. Original bearing trees; --- Sugar 16" N.17 E., 16 links (10.56') --- Sugar 9" N.15 W., 30 links (19.80') --- Black Oak 20" S.79 E., 45 links (29.70') --- Sugar 10" S.34 W., 60 links (39.60') ---

Corner recovered by Donald D. Lappala, RLS 12585 on 8/26/65 from retracement measurement to natural features and corners west and south. He set a 2" X 5" iron pipe monument with a stamped brass cap and the following new bearing trees; --- 10" Sugar Maple N.43 W., 24.7' --- 10" Sugar Maple N.07 W., 17.4' --- 8" Elm N.35 E., 27.3' ---. Corner recorded in Ontonagon County in USFS

B. Description of corner evidence found and/or method applied in restoring or reestablishing corner:
Liber, Page Z-9 on 6/3/68.


Act 74 research on file.

Recovered Lappalas damaged monument on the north edge of a power line clearing and his BT s as follows: --- 11" Sugar Maple N.40 W., 24.63' --- 11" Sugar Maple North, 17.40' --- 13" Elm stub N.40 E., 26.99" --- and 1984 bearing trees by R.L. Drahn and C.M. Story --- 14" Sugar Maple S.07 E., 59.93' --- 14" Sugar Maple S.46 W., 67.67' ---.

Resource grade GPS
Lat. 46-40.728 N
Long. 89-34.368 W

PEER GROUP APPROVED
Carl W. Applekamp
COUNTY REPRESENTATIVE 7-18-95

C. Description of monument for corner and accessories established to perpetuate locating the position of the corner:
I replaced Mr. Lappalas monument with a 2 1/2" X 30" aluminum monument with a 3 1/4" stamped aluminum cap and the following reference objects: --- 6' Steel Sign Rail N.24 E., 1.54' --- 4" X 4" X 7' Wood Sign Post (1965) N.51 W., 2.1' ---. Damaged 1965 monument now lays on ground at site.

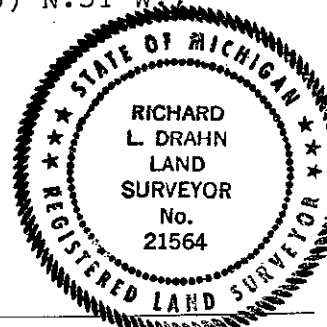

Signed by Richard L. Drahn Date July 4, 1995
Surveyor's Michigan License No. 21564