

SURVEY & REMONUMENTATION

APR 29 1996

COMMISSION

LAND CORNER RECORDATION CERTIFICATE
Filing Requirement of Act 74, Mich. P.A. 1970

JUDITH D. ROEHN
Ontonagon County
LC 3/367 MEL Fee: 9.00
10/26/95 14:07
Page 1 of 1

For corners in	Located In:	Corner Code #
<u>ONTONAGON</u> (County)		
1. Public Land Survey	T 49 R 42	E-11
	T _____ R _____	_____
	T _____ R _____	_____
	T _____ R _____	_____
2. Property Controlling in Section	S _____ T _____ R _____	_____
	S _____ T _____ R _____	_____
3. Miscellaneous Property in Section	S _____ T _____ R _____	_____
	S _____ T _____ R _____	_____

Register of Deeds Stamp & File Number

4. Lot No. _____, Recorded Plat _____
5. Private Claims _____

Section Corner common to Sections 28, 29, 32 & 33, T49N R42W.

I, Earl W. Applekamp, in a field survey on April 14, 19 95, do hereby certify that under requirements of P.A. 74, Michigan P.A. of 1970, the corner points mentioned in lines 1 and 2 above were in conformance with regulations and rules therefore as required in the current manual of survey instructions of the United States Department of the Interior, Bureau of Land Management or by a decree of a Court of Law and/or that the corner points mentioned in lines 3, 4 and 5 above were in conformance with the rules of the Michigan Board of Professional Surveyors or by a Decree of a Court of Law; established, re-established, monumented, re-monumented, recovered, found as expressed below:

NOTE: Not more than 4 corners, all in the same town and range, may be recorded on this certificate.

A	B	C	D	E	F	G	H	I	J	K	L	M
2	6	5	4	3	2							
3												
4	7	8	9	10	11	12						
6												
6	18	17	16	15	14	13						
7												
8	19	20	21	22	23	24						
9												
10	30	29	28	27	26	25						
11												
12	31	32	33	34	35	36						
13												

A. Description of original monument and accessories and/or subsequent restoration:

Original Corner established by William Burt, U.S. Deputy Surveyor, June 1848. Set Sugar Post.

BEARING TREES:

Hemlock 24" S35°E 33 links (21.78 feet)
Hemlock 14" N55°W 7 links (4.62 feet)


B. Description of corner evidence found and/or method applied in restoring or reestablishing corner:

At the corner position I found the remains of two 1" Iron Pins; These were called for in a M.D.O.T. survey, July 1957. These were replaced with a 1" drill steel by E.W. Applekamp, June 1972. This drill steel was used for several surveys in the area. These iron pins and the drill steel were removed. The drill steel position was replaced with a monument described in "C" below.

Research on file with County Remonumentation Program Representative.

PEER GROUP APPROVED

Earl W. Applekamp 10-18-95
COUNTY REPRESENTATIVE

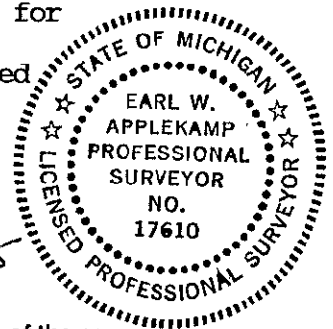

C. Description of monument for corner and accessories established to perpetuate locating the position of the corner:

At the corner position I set a 2 1/2"x30" aluminum pipe with a 3 1/4" cap stamped to read: T49N R42W, S28, S29, S32, S33, 1995, P.S. 17610. I established the following bearing trees and reference objects.

9" Oak N56°E 72.27 feet - Nail in Power Pole N81°E 25.06 feet
11" Oak S38°E 74.50 feet - Steel Sign Post West 1.60 feet

Signed by Earl W. Applekamp

Date September 19, 1995

Surveyor's Michigan License No. 17610