

**SURVEY & REMONUMENTATION**

APR 29 1996

**COMMISSION**

**LAND CORNER RECORDATION CERTIFICATE**  
Filing Requirement of Act 74, Mich. P.A. 1970

JUDITH D. ROEHM  
Ontonagon County  
LC 3/ 283 JEM Fee: 9.00  
Page 1 of 1

For corners in

<u>Ontonagon</u> (County)	Located In:	Corner Code #
1. Public Land Survey	T 50N R 42 W	F-13
	T 49 R 42	<u>F-1</u>
	T _____ R _____	_____
	T _____ R _____	_____
2. Property Controlling in Section	S _____ T _____ R _____	_____
	S _____ T _____ R _____	_____
3. Miscellaneous Property in Sec.	S _____ T _____ R _____	_____
	S _____ T _____ R _____	_____

Register of Deeds Stamp & File Number

4. Lot No. \_\_\_\_\_, Recorded Plat \_\_\_\_\_  
5. Private Claims \_\_\_\_\_

Quarter Corner 33 and 4; T.49-50 N., R.42 W.

I, Richard L. Drahn, in a field survey on June 8, 19 95, do hereby certify that under requirements of P.A. 74, Michigan P.A. of 1970, the corner points mentioned in lines 1 and 2 above were in conformance with regulations and rules therefore as required in the current manual of survey instructions of the United States Department of the Interior, Bureau of Land Management or by a decree of a Court of Law and/or that the corner points mentioned in lines 3, 4 and 5 above were in conformance with the rules of the Michigan Board of Land Surveyors or by a Decree of a Court of Law; established, re-established, monumented, re-monumented, recovered, found as expressed below:

**NOTE: Not more than 4 corners, all in the same town and range, may be recorded on this certificate.**

A	B	C	D	E	F	G	H	I	J	K	L	M
2	6	5	4	3	2	1						
3												
4	7	8	9	10	11	12						
5												
6	13	17	16	15	14	13						
7												
8	19	20	21	22	23	24						
9												
10	30	29	28	27	26	25						
11												
12	31	32	33	34	35	36						
13												

A. Description of original monument and accessories and/or subsequent restoration:  
Corner established by William Burt on August 18, 1847. Original BTs --- 9" Sugar N.30 E., 11 links (7.26') --- 5" Lynn N.42 W., 11 links (7.26') ---.

Corner recovered by Richard L. Drahn, RLS 21564 from the remains of the two original bearing trees and retracement distances to recovered section corners east and west. He set a 2" x 5' iron pipe monument with a 3" brass cap stamped to identify the corner and established the following new bearing objects: (1995 conditions in parenthesis)

10" (12") N. Red Oak N.43 E. (N.45 E.) 32.3 ft. (32.43')

B. Description of corner evidence found and/or method applied in restoring or reestablishing corner:

6" (6") Sugar Maple S.25 E. (S.22 E.) 44.5 ft. (44.24')  
10" (14") N. Red Oak S.51 W. (S.55 W.) 67.1 ft. (67.15')  
7' Steel rail South (S.05 W.) 1.7 ft. (1.65')

Corner monument recovered as described and in good condition.


Corner recorded in Liber 1, Page 156 of Ontonagon County Records on 4/25/79.

PEER GROUP APPROVED  
*Earl W. Applekamp* 7-18-95  
COUNTY REPRESENTATIVE

Resource grade GPS  
Lat. 46-40.768 N  
Long. 89-33.840 W

C. Description of monument for corner and accessories established to perpetuate locating the position of the corner:  
From the above described monument I blazed and scribed the following:

4" Sugar Maple N.35 W. 22.85 feet

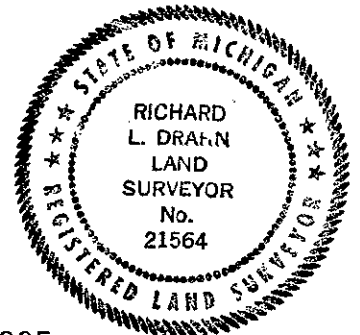

Signed by Richard L. Drahn Date June 9, 1995  
Surveyor's Michigan License No. 21564