

LAND CORNER RECORDATION CERTIFICATE  
 Filing Requirement of Act 74, Mich. P.A. 1970

For corners in  
ONTONAGON  
 (County)

Located in: Corner Code #


1. Public Land Survey T49N R 42W G-10  
 T R  
 T R  
 T R

2. Property Controlling in Section S T R  
 S T R  
 S T R

3. Miscellaneous Property in Sec. S T R  
 S T R

4. Lot No. \_\_\_\_\_, Recorded Plat \_\_\_\_\_  
 5. Private Claims \_\_\_\_\_

SURVEY &  
 REMONUMENTATION  
 MAR 23 2000  
 SECTION  
 Register of Deeds Stamp & File Number

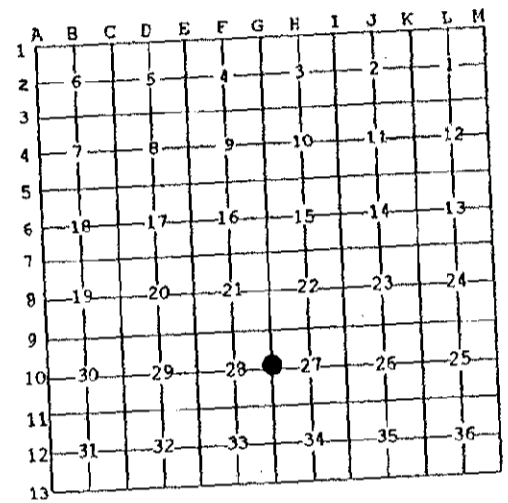

1/4 Corner common to Sections 27 & 28, T49N R42W.  
 I, Earl W. Applekamp, in a field survey on Nov. 19, 1999 do hereby state that under requirements of P.A. 74, Michigan P.A. of 1970, the corner points mentioned in lines 1 and 2 above were in conformance with regulations and rules therefore as required in the current manual of survey instructions of the United States Department of the Interior, Bureau of Land Management or by a decree of a Court of Law and/or that the corner points mentioned in lines 3, 4 and 5 above were in conformance with the rules of the Michigan Board of Land Surveyors or by a Decree of a Court of Law; established, re-established, monumented, recovered, found as expressed below:

NOTE: Not more than 2 corners, all in the same town and range, may be recorded on this certificate.

A. Description of original monument and accessories and/or subsequent restoration:  
 Original Corner established by William Burt, U.S. Deputy Surveyor, June 9, 1848. Set Cedar Post.

ORIGINAL BEARING TREES:  
 Spruce 18" N64°E 8 Links ( 5.28 Feet)  
 Sugar 9" S55°W 32 Links (21.12 Feet)


PEER GROUP APPROVED  
Earl W. Applekamp  
 COUNTY REPRESENTATIVE  
 11-30-99

B. Description of corner evidence found and/or method applied in restoring or reestablishing corner:  
 No original evidence was found. Area has been logged extensively years ago and has been clear cut 2 years ago. Corner was re-established by proportionate measure and on line between opposite Section Corners North and South.

Research on file with the Ontonagon County Remonumentation Program Representative.

C. Description of monument for corner and accessories established to perpetuate locating the position of the corner:  
 At the corner position I set a 2 1/2" X 30" split base aluminum pipe with a 3" cap stamped to read: County Remonumentation, T49N R42W, S27, S28, 1/4, 1999, P.S. 17610. I established three bearing trees and a reference monument.

Nail in 4" Balsam N65°W 40.72' - Nail in 10" Cedar S71°E 98.10'  
 Nail in 5" B. Ash N75°E 83.58' - 6' Steel Sign Post, West 0.45'

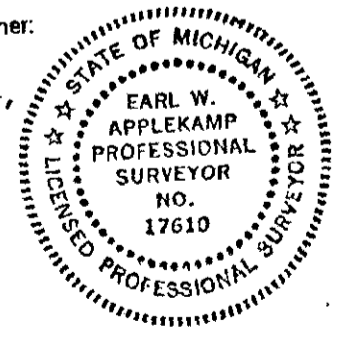

Signed by Earl W. Applekamp  
 Surveyor's Michigan License No. 17610

Date November 29, 1999