

LAND CORNER RECORDATION CERTIFICATE  
 Filing Requirement of Act 74, Mich. P.A. 1970

For corners in

ONTONAGON (County)	Located In:	Corner Code #
1. Public Land Survey	T <u>49</u> NR <u>42</u> W	<u>G-12</u>
	T ___ R ___	_____
	T ___ R ___	_____
	T ___ R ___	_____
2. Property Controlling in Section	S ___ T ___ R ___	_____
	S ___ T ___ R ___	_____
3. Miscellaneous Property in Sec.	S ___ T ___ R ___	_____
	S ___ T ___ R ___	_____

SURVEY &  
 REMONUMENTATION

MAR 23 2000

SECTION

Register of Deeds Stamp & File Number

4. Lot No. \_\_\_\_\_, Recorded Plat \_\_\_\_\_  
 5. Private Claims \_\_\_\_\_

$\frac{1}{4}$  Corner common to Sections 33 & 34, T49N R42W.

I, Earl W. Applekamp, in a field survey on Nov. 20, 1999 do hereby state that under requirements of P.A. 74, Michigan P.A. of 1970, the corner points mentioned in lines 1 and 2 above were in conformance with regulations and rules therefore as required in the current manual of survey instructions of the United States Department of the Interior, Bureau of Land Management or by a decree of a Court of Law and /or that the corner points mentioned in lines 3, 4 and 5 above were in conformance with the rules of the Michigan Board of Land Surveyors or by a Decree of a Court of Law; established, re-established, monumented, recovered, found as expressed below:

NOTE: Not more than 2 corners, all in the same town and range, may be recorded on this certificate.

	A	B	C	D	E	F	G	H	I	J	K	L	M
1													
2	6		5		4		3		2		1		
3													
4	7		8		9		10		11		12		
5													
6	18		17		16		15		14		13		
7													
8	19		20		21		22		23		24		
9													
10	30		29		28		27		26		25		
11													
12	31		32		33		34		35		36		
13													

A. Description of original monument and accessories and/or subsequent restoration:

Original Corner established by William Burt, U.S. Deputy surveyor, June 8, 1848. Set W. Ash Post.

ORIGINAL BEARING TREES:


Spruce 12" N62°E 13 Links (8.58 Feet)  
 Sugar 12" S62°W 15 Links (9.90 Feet)

B. Description of corner evidence found and/or method applied in restoring or reestablishing corner:

No original or subsequent evidence was found. Corner was re-established by proportionate measure and on line between opposite Section corners North and South.

Research on file with the Ontonagon County Remonumentation Program Representative.

PEER GROUP APPROVED  
*Earl W. Applekamp*  
 COUNTY REPRESENTATIVE 11-30-99

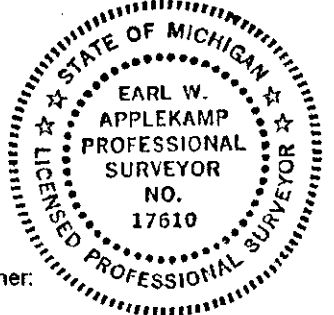

C. Description of monument for corner and accessories established to perpetuate locating the position of the corner:

At the corner position I set a 2 1/2" X 30" split base aluminum pipe with a 3" cap stamped to read: County Remonumentation, T49N R42W, 1/4, S33, S34, 1999, P.S. 17610. I established three bearing trees and a reference object.

Nail in 11" Maple N50°W 19.39' - Nail in 12" Hemlock S20°E 46.19'  
 Nail in 9" H. Maple N83°E 35.07' - 6' Steel Sign Post North 0.76'

Signed by Earl W. Applekamp  
 Surveyor's Michigan License No. 17610

Date November 26, 1999