

**SURVEY & REMONUMENTATION**

APR 29 1996

**COMMISSION**

JUDITH D. ROEHM 09/25/95  
 Ontonagon County 14:39  
 LC 3/317 JEM Fee: 9.00  
 Page 1 of 1

**LAND CORNER RECORDATION CERTIFICATE**  
 Filing Requirement of Act 74, Mich. P.A. 1970

For corners in  
Ontonagon  
 (County)

Located In: Corner Code #

- |                                    |                             |            |
|------------------------------------|-----------------------------|------------|
| 1. Public Land Survey              | T <u>49N</u> R <u>42W</u> . | <u>H-3</u> |
|                                    | T _____ R _____             | _____      |
|                                    | T _____ R _____             | _____      |
|                                    | T _____ R _____             | _____      |
| 2. Property Controlling in Section | S _____ T _____ R _____     | _____      |
|                                    | S _____ T _____ R _____     | _____      |
| 3. Miscellaneous Property in Sec.  | S _____ T _____ R _____     | _____      |
|                                    | S _____ T _____ R _____     | _____      |

Register of Deeds Stamp & File Number

4. Lot No. \_\_\_\_\_, Recorded Plat \_\_\_\_\_  
 5. Private Claims \_\_\_\_\_

1/4 Corner 3 & 10; T.49 N., R.42 W.

I, Richard L. Drahn, in a field survey on August 21, 19 95

do hereby certify that under requirements of P.A. 74, Michigan P.A. of 1970, the corner points mentioned in lines 1 and 2 above were in conformance with regulations and rules therefore as required in the current manual of survey instructions of the United States Department of the Interior, Bureau of Land Management or by a decree of a Court of Law and/or that the corner points mentioned in lines 3, 4 and 5 above were in conformance with the rules of the Michigan Board of Land Surveyors or by a Decree of a Court of Law; established, re-established, monumented, re-monumented, recovered, found as expressed below:

**NOTE: Not more than 4 corners, all in the same town and range, may be recorded on this certificate.**

	A	B	C	D	E	F	G	H	I	J	K	L	M
2	6	5	4	3	2	1							
3								●					
4	7	8	9	10	11	12							
5													
6	18	17	16	15	14	13							
7													
8	19	20	21	22	23	24							
9													
10	30	29	28	27	26	25							
11													
12	31	32	33	34	35	36							
13													

A. Description of original monument and accessories and/or subsequent restoration:

Corner established by William Burt in 1848. Original B.T.s --- Sugar Maple 7" N.41 E., 34 links (22.44') --- Sugar Maple 14" S.25 E. 10 links (6.6').

Corner restored by Donald D. Lappala, RLS 12585 on 15/10/69 from the decayed remains of both original bearing trees and a natural feature tie east. He set a 2½" by 5' galvanized iron pipe with a 3" stamped brass cap and the following new bearing trees: --- 5" Sugar Maple (now dead and down) N.21W. 20.2' --- 10" Elm (now dead) N.61E. 38.8' --- 10" elm (now dead) S.19 E. 25.8'.

B. Description of corner evidence found and/or method applied in restoring or reestablishing corner.

Act 74 research form of file with Ontonagon County Records.

Recovered the monument as described and all bearing trees dead.

Monument set in a mound of large rock at base of exposed ledge rock.

PEER GROUP APPROVED

*Earl Applekamp 9-20-95*  
 COUNTY REPRESENTATIVE

C. Description of monument for corner and accessories established to perpetuate locating the position of the corner:


Referenced the following new bearing trees:

5" Sugar Maple N.12 W. 13.04'

5" Sugar Maple S.03 W. 16.55'

6" Sugar Maple S.66 W. 22.04'

Signs on a unblazed 13" Basswood S.50 E. 25.48'

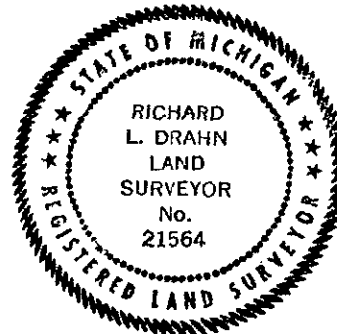

Signed by Richard L. Drahn Date September 10, 1995

Surveyor's Michigan License No. 21564