

SURVEY & REMONUMENTATION

APR 26 1996

LAND CORNER RECORDATION CERTIFICATE Filing Requirement of Act 74, Mich. P.A. 1970

B
Gb.
Gb.
B

For corners in **COMMISSION**

<u>ONTONAGON</u> <small>(County)</small>	Located In:	Corner Code #
1. Public Land Survey	48 N 42W T 49 NR 42	I-1 I-13
2. Property Controlling in Section	S T R	
3. Miscellaneous Property in Sec.	S T R	

Recorded: October 19 1994
at 2:13 o'clock P. M. in
Liber 3 page 211
Jessie M. Avelly
Register of Deeds


Register of Deeds Stamp & File Number

4. Lot No. _____, Recorded Plat _____
5. Private Claims _____

Section Corner 2, 3, 34 & 35, T48 & 49N R42W

Earl W. Applekamp
in a field survey on October 01 1994

I do hereby certify that under requirements of P.A. 74, Michigan P.A. of 1970, the corner points mentioned in lines 1 and 2 above were in conformance with regulations and rules therefore as required in the current manual of survey instructions of the United States Department of the Interior, Bureau of Land Management or by a decree of a Court of Law and/or that the corner points mentioned in lines 3, 4 and 5 above were in conformance with the rules of the Michigan Board of Land Surveyors or by a Decree of a Court of Law; established, re-established, monumented, re-monumented, recovered, found as expressed below:

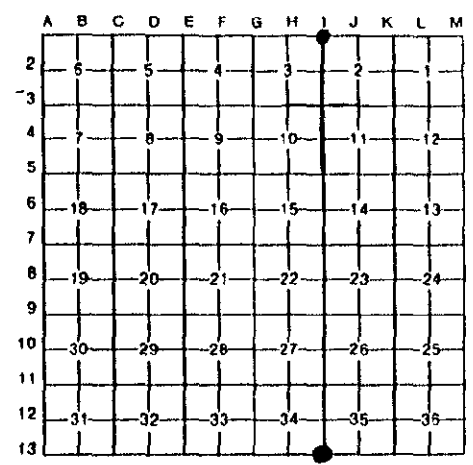

NOTE: Not more than 4 corners, all in the same town and range, may be recorded on this certificate.

A. Description of original monument and accessories and/or subsequent restoration:

- Yellow Birch Post
- Sugar 12" N69°E 32 links (21.12 feet)
- Hemlock 10" N18°W 38 links (25.08 feet)

ONTONAGON COUNTY
PEER APPROVED
Earl W. Applekamp
Ontonagon Co. Rep.
10-12-94

B. Description of corner evidence found and/or method applied in restoring or reestablishing corner:

Found 1 1/2" pipe with 3 ties at the corner location and accepted this being the corner location because of the long time this corner was marked. In a survey conducted in 1993 this location was checked with established corners to the South and West and was in general agreement with the original survey. Based on all this evidence I replaced the 1 1/2" pipe with a permanent monument described below.

Research on file with County Remonumentation Representative

C. Description of monument for corner and accessories established to perpetuate locating the position of the corner:

At the corner position I set a 2 1/2"x30" long aluminum pipe with a 3 1/4" cap, stamped to read: County Remonumentation, Section 2, 3, 34, 35, T48N & T49N, R42W 1994, P.S. 17610. The corner was tied to the following trees and objects.

- | | | | | | | | |
|-----------|-----|-------|--------|-----------------|-------|-------|--------|
| Twin Oaks | 14" | N06°E | 35.59' | Sugar | 14" | S73°E | 15.35' |
| White Ash | 12" | S42°W | 22.65' | Steel Sign Post | North | 1.75' | |

Signed by *Earl W. Applekamp* Date October 07, 1994
Surveyor's Michigan License No. 17610

