

APR 29 1995

COMMISSION

JUDITH D. ROEHM
Ontonagon County
LC 3/394 JEM Fee: 9.00
10/26/95 08:08
Page 1 of 1

LAND CORNER RECORDATION CERTIFICATE
Filing Requirement of Act 74, Mich. P.A. 1970

For corners in ONTONAGON
(County)

Located In:

Corner Code #

1. Public Land Survey	T	49	R	41	A-11
	T	49	R	42	M-11 ✓
	T		R		
	T		R		
2. Property Controlling in Section	S		T	R	
	S		T	R	
3. Miscellaneous Property in Section	S		T	R	
	S		T	R	

Register of Deeds Stamp & File Number

4. Lot No. _____, Recorded Plat _____
5. Private Claims _____

Section Corner common to 25, 30, 31, & 36, T49N R41 & 42W.

I, Earl W. Applekamp, in a field survey on July 17, 1995, do hereby certify that under requirements of P.A. 74, Michigan P.A. of 1970, the corner points mentioned in lines 1 and 2 above were in conformance with regulations and rules therefore as required in the current manual of survey instructions of the United States Department of the Interior, Bureau of Land Management or by a decree of a Court of Law and/or that the corner points mentioned in lines 3, 4 and 5 above were in conformance with the rules of the Michigan Board of Professional Surveyors or by a Decree of a Court of Law; established, re-established, monumented, re-monumented, recovered, found as expressed below:

A	B	C	D	E	F	G	H	I	J	K	L	M
2	6		5		4		3		2		1	
3												
4	7		8		9		10		11		12	
5												
6	18		17		16		15		14		13	
7												
8	19		20		21		22		23		24	
9												
10	30		29		28		27		26		25	
11												
12	31		32		33		34		35		36	
13												

NOTE: Not more than 4 corners, all in the same town and range, may be recorded on this certificate.

A. Description of original monument and accessories and/or subsequent restoration:

Original corner established by William A. Burt, U.S. Deputy Surveyor, summer 1847. Set Post.

ORIGINAL BEARING TREES:

Lynn	12"	S27°W	13 links	(8.58 feet)
Sugar	9"	N20°E	40 links	(26.40 feet)

B. Description of corner evidence found and/or method applied in restoring or reestablishing corner:


No evidence of original corner was found. The corner location was re-established using the original survey notes. Calls to top of a hill, the West branch of the Ontonagon River to the North and to the West were used to relocate the corner in its original position. The location of the Corner set is consistent with the original field notes.

Research on this corner filed with the County Remonumentation Representative.

PEER GROUP APPROVED
Earl W. Applekamp
COUNTY REPRESENTATIVE 10-18-95

C. Description of monument for corner and accessories established to perpetuate locating the position of the corner:

At the corner position I set a 1½"x30" aluminum pipe with a 3¼" cap stamped to read: COUNTY REMONUMENTATION, S25, S30, S31, S36, T49N R41W, R42W, 1995, P.S. 17610. I established the following bearing trees and reference objects.

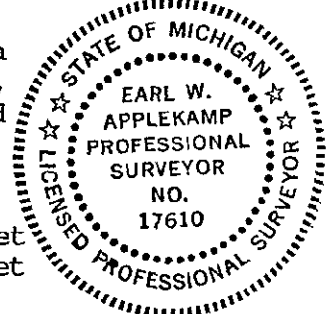

3" Aspen	S77°W	18.71 feet	-	4" Aspen	N62°E	13.76 feet
7" Basswood	S64°E	8.43 feet	-	Steel Sign Post	South	1.25 feet

Signed by *Earl W. Applekamp*
Surveyor's Michigan License No. 17610

Date July 29, 1995