

**SURVEY &
REMONUMENTATION**

APR 29 1996

COMMISSION

JUDITH D. ROEHL 10/26/95
Ontonagon County 08:10
LC 3/400 JEM Fee: 9.00
Page 1 of 1

LAND CORNER RECORDATION CERTIFICATE
Filing Requirement of Act 74, Mich. P.A. 1970

For corners in ONTONAGON Located In: _____ Corner Code # _____
(County)


- | | | | |
|--------------------------------------|-------------|-------------|---------------|
| 1. Public Land Survey | T <u>48</u> | R <u>41</u> | <u>A-1</u> |
| | T <u>48</u> | R <u>42</u> | <u>M-1</u> |
| | T <u>49</u> | R <u>41</u> | <u>A-13</u> |
| | T <u>49</u> | R <u>42</u> | <u>M-13</u> ✓ |
| 2. Property Controlling in Section | S _____ | T _____ | R _____ |
| 3. Miscellaneous Property in Section | S _____ | T _____ | R _____ |

Register of Deeds Stamp & File Number

4. Lot No. _____, Recorded Plat _____
5. Private Claims _____

Section Corner common to Sections 1, 6, 31 & 36,
T48-T49N, R41-R42W.

I, Earl W. Applekamp, in a field survey on July 17, 1995, do hereby certify that under requirements of P.A. 74, Michigan P.A. of 1970, the corner points mentioned in lines 1 and 2 above were in conformance with regulations and rules therefore as required in the current manual of survey instructions of the United States Department of the Interior, Bureau of Land Management or by a decree of a Court of Law and/or that the corner points mentioned in lines 3, 4 and 5 above were in conformance with the rules of the Michigan Board of Professional Surveyors or by a Decree of a Court of Law; established, re-established, monumented, re-monumented, recovered, found as expressed below:

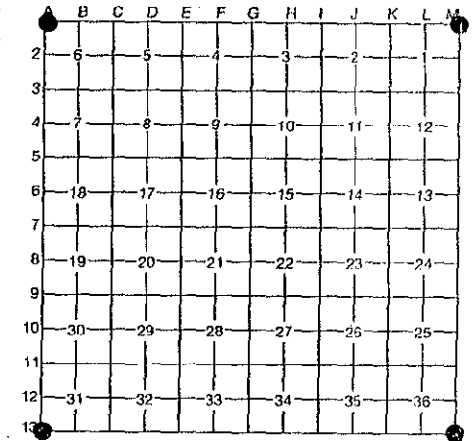

NOTE: Not more than 4 corners, all in the same town and range, may be recorded on this certificate.

A. Description of original monument and accessories and/or subsequent restoration:

Original corner established by William A. Burt, U.S. Deputy Surveyor, 1847. Set Hemlock Post.

ORIGINAL BEARING TREES:

Sugar	16"	N30°E	20 Links (13.20 feet)
Maple	16"	S38°W	21 Links (13.86 feet)

B. Description of corner evidence found and/or method applied in restoring or reestablishing corner:

No evidence of original corner was found. A cedar post was found near the corner position. An old fence (60 yrs. ±) runs West from the North ¼ corner of Section 6 but ends about 400 feet East of the NW corner of Section 6. A projection of this fence places the corner 83 feet North of the Cedar Post. This location is in better agreement with the original field note calls. I monumented the corner as described in "C" below. This corner is one of 29 corners in 6 Sections remonumented under the County Remonumentation Program. Research is on file with the Ontonagon County Remonumentation Representative.


PEER GROUP APPROVED

Earl W. Applekamp
COUNTY REPRESENTATIVE 10-18-95

C. Description of monument for corner and accessories established to perpetuate locating the position of the corner:

At the corner position I set a 2½"x30" aluminum pipe with a 3¼" cap stamped to read: COUNTY REMONUMENTATION, S1, S6, S31, S36, T48N, R41W R42W, 1995, P.S. 17610. I established the following bearing trees and reference objects:

9" Ash	S36°W	25.23 feet	5" Maple	North	15.77 feet
7" Maple	N70°E	19.47 feet	Steel Sign Post,	South	1.50 feet

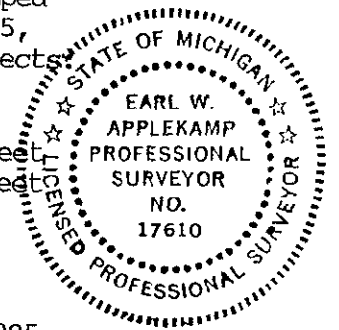

Signed by Earl W. Applekamp
Surveyor's Michigan License No. 17610

Date July 22, 1995