

**SURVEY & REMONUMENTATION**

APR 29 1995

**COMMISSION**

**LAND CORNER RECORDATION CERTIFICATE**  
**Filing Requirement of Act 74, Mich. P.A. 1970**

JUDITH D. ROEHN  
 Ontonagon County  
 LC 3/275 JEM Fee: .00  
 Page 1 of 1  
 05/02/95  
 14:13

For corners in

ONTONAGON  
 (County)

Located In:

Corner Code #1

- |                                    |                             |       |
|------------------------------------|-----------------------------|-------|
| 1. Public Land Survey              | T <u>49N.</u> R <u>43W.</u> | B-13  |
|                                    | T _____ R _____             | _____ |
|                                    | T _____ R _____             | _____ |
|                                    | T _____ R _____             | _____ |
| 2. Property Controlling in Section | S _____ T _____ R _____     | _____ |
|                                    | S _____ T _____ R _____     | _____ |
| 3. Miscellaneous Property in Sec.  | S _____ T _____ R _____     | _____ |
|                                    | S _____ T _____ R _____     | _____ |

**Register of Deeds Stamp & File Number**

4. Lot No. \_\_\_\_\_, Recorded Plat \_\_\_\_\_  
 5. Private Claims \_\_\_\_\_

$\frac{1}{4}$  Corner, Sections 31 & 6; T.48-49N., R.43W.

I, Richard L. Drahn, in a field survey on September 9, 1994

do hereby certify that under requirements of P.A. 74, Michigan P.A. of 1970, the corner points mentioned in lines 1 and 2 above were in conformance with regulations and rules therefore as required in the current manual of survey instructions of the United States Department of the Interior, Bureau of Land Management or by a decree of a Court of Law and/or that the corner points mentioned in lines 3, 4 and 5 above were in conformance with the rules of the Michigan Board of Land Surveyors or by a Decree of a Court of Law; established, re-established, monumented, re-monumented, recovered, found as expressed below:

A	B	C	D	E	F	G	H	I	J	K	L	M
2	6	5	4	3	2	1						
3												
4	7	8	9	10	11	12						
5												
6	18	17	16	15	14	13						
7												
8	19	20	21	22	23	24						
9												
10	30	29	28	27	26	25						
11												
12	31	32	33	34	35	36						
13												

**NOTE: Not more than 4 corners, all in the same town and range, may be recorded on this certificate.**

A. Description of original monument and accessories and/or subsequent restoration:

Corner established by John Burt, US Deputy Surveyor, in 1847. Original bearing trees:

Yellow Birch	6"	N.53E.	45 links	(29.70 feet)
Spruce	8"	N.24W.	24 links	(15.84 feet)

B. Description of corner evidence found and/or method applied in restoring or reestablishing corner:

No G.L.O. evidence remains. Corner position re-established by proportionate methods between the SW & SE corners of section 31; T.49N., R.43W.

**ONTONAGON COUNTY**


**PEER APPROVED**

*Earl W. Applekamp*  
*Dist. Co. Rep.*  
*Jan 25, 1995*

C. Description of monument for corner and accessories established to perpetuate locating the position of the corner:

At the corner position I set a 3/4" x 7' solid aluminum marsh rod with a 3/4" aluminum cap with magnet, stamped to read: T.48-49N., R.43W.;  $\frac{1}{4}$ ; S-31, S-36; 1994; R.L.S. 21564; from which I established the following new blazed and scribed bearing trees and/or objects:

6"	Black Ash	N.35W.	25.09 feet
10"	Black Ash	S.15E.	11.17 feet
18"	Cedar	S.72W.	12.35 feet
6'	Steel rail	N.57E.	1.09 feet

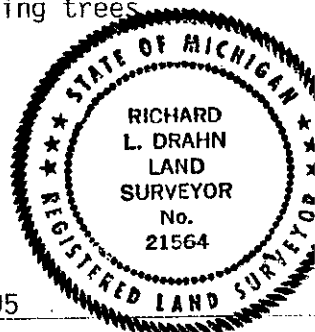

Signed by Richard L. Drahn Date January 25, 1995  
 Surveyor's Michigan License No. 21564