

DEC 16 1996

COMMISSION

JUDITH D. ROEHM
Ontonagon County
LC 4/117 JEM Fee: 9.00
Page 1 of 1

LAND CORNER RECORDATION CERTIFICATE
Filing Requirement of Act 74, Mich. P.A. 1970

For corners in

<u>Ontonagon</u> (County)	Located In:	Corner Code #
1. Public Land Survey	T <u>49N</u> R <u>43W</u>	<u>E-12</u>
	T _____ R _____	_____
	T _____ R _____	_____
	T _____ R _____	_____
2. Property Controlling in Section	S _____ T _____ R _____	_____
	S _____ T _____ R _____	_____
3. Miscellaneous Property in Sec.	S _____ T _____ R _____	_____
	S _____ T _____ R _____	_____

Register of Deeds Stamp & File Number

4. Lot No. _____, Recorded Plat _____
5. Private Claims _____

1/4 Corner 32 & 33; T.49 N., R.43 W.

Richard L. Drahn, in a field survey on June 12, 1996, do hereby certify that under requirements of P.A. 74, Michigan P.A. of 1970, the corner points mentioned in lines 1 and 2 above were in conformance with regulations and rules therefore as required in the current manual of survey instructions of the United States Department of the Interior, Bureau of Land Management or by a decree of a Court of Law and/or that the corner points mentioned in lines 3, 4 and 5 above were in conformance with the rules of the Michigan Board of Land Surveyors or by a Decree of a Court of Law; established, re-established, monumented, re-monumented, recovered, found as expressed below:

NOTE: Not more than 4 corners, all in the same town and range, may be recorded on this certificate.

	A	B	C	D	E	F	G	H	I	J	K	L	M
2	6	5	4	3	2	1							
3													
4	7	8	9	10	11	12							
5													
6	16	17	18	15	14	13							
7													
8	19	20	21	22	23	24							
9													
10	30	29	28	27	26	25							
11													
12	31	32	33	34	35	36							
13													

A. Description of original monument and accessories and/or subsequent restoration:

Corner established by William Burt on July 3, 1848. Original B.T.S --- Cedar 14" S.85 E. 27 links (17.82') --- Spruce 12" N.10 W. 10 links (6.60') Corner restored by Donald D. Lappala, RLS 12585 on 5/7/71 from the decayed remains of the Cedar B.T. (with GLO blazes) and from line trees north and south and a natural feature tie south. He set a 2 1/2" dia. iron pipe with a 3" stamped brass cap and the following new B.T.s: --- 9" (10") Yellow Birch N.62 W. (N.61 W.) 49.1' (49.04') --- 9" (13") Cedar N.58-30 E. (N.57 E.) 54.1' (54.11') --- 9" Cedar (14") S.09-30 W. (S.08 W.) 5.4' (5.17') --- Corner recorded in Ontonagon County in USFS Liber, Page X-9 on 9/14/72.

B. Description of corner evidence found and/or method applied in restoring or reestablishing corner:

Act 74 research form on file with Ontonagon County records.

Recovered the monument as described and the bearing trees as noted in parentheses above. The original B.T. is now a broken Cedar stub with GLO blazes.


PEER GROUP APPROVED

Earl W. Applekamp
COUNTY REPRESENTATIVE

C. Description of monument for corner and accessories established to perpetuate locating the position of the corner: 07-08-96

New bearing objects referenced:

- 4" X 4" Cedar sign post N.51 E. 5.2'
- 6" Steel sign rail N.63 W. 3.1'

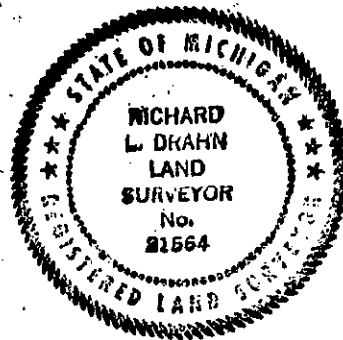

Signed by Richard L. Drahn

Date June 13, 1996

Surveyor's Michigan License No. 21564

USFS X-9