

APR 29 1996

COMMISSION

LAND CORNER RECORDATION CERTIFICATE  
Filing Requirement of Act 74, Mich. P.A. 1970

JUDITH D. ROEHM  
Ontonagon County

05/09/95  
14:11

3/274 JEM Fee: .00  
Page 1 of 1

For corners in  
ONTONAGON  
(County)

Located In: Corner Code #

1. Public Land Survey	T	49N.	R	43W.	F#-11
	T		R		
	T		R		
	T		R		
2. Property Controlling in Section	S		T	R	
	S		T	R	
3. Miscellaneous Property in Sec.	S		T	R	
	S		T	R	


Register of Deeds Stamp & File Number

4. Lot No. \_\_\_\_\_, Recorded Plat \_\_\_\_\_  
5. Private Claims \_\_\_\_\_

1/4 Corner, Sections 28 & 33; T.49N., R.43W.

I, Richard L. Drahn, in a field survey on October 3, 1994, do hereby certify that under requirements of P.A. 74, Michigan P.A. of 1970, the corner points mentioned in lines 1 and 2 above were in conformance with regulations and rules therefore as required in the current manual of survey instructions of the United States Department of the Interior, Bureau of Land Management or by a decree of a Court of Law and/or that the corner points mentioned in lines 3, 4 and 5 above were in conformance with the rules of the Michigan Board of Land Surveyors or by a Decree of a Court of Law; established, re-established, monumented, re-monumented, recovered, found as expressed below:

NOTE: Not more than 4 corners, all in the same town and range, may be recorded on this certificate.

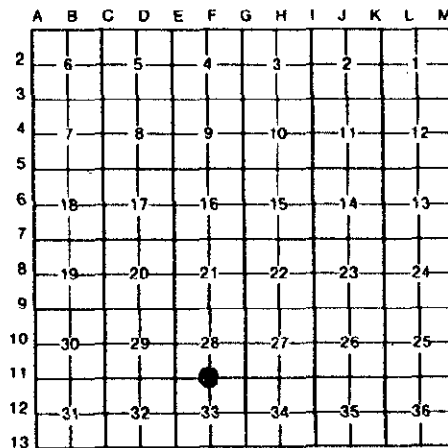

A. Description of original monument and accessories and/or subsequent restoration:

Corner established by William Burt, US Deputy Surveyor, on July 3, 1848. Original bearing trees:

Maple	5"	N.76E.	15 links	( 9.90 feet)
Hemlock	18"	S.55W.	27 links	(17.82 feet)

B. Description of corner evidence found and/or method applied in restoring or reestablishing corner:

Restored corner position from the stump remains of the hemlock bearing tree; it is now a large, almost completely decayed hemlock stump, bark and large knots are all that remain. The red maple b.t. has been destroyed by logging road construction. Distance east and west to recovered section corners is in accord with the field notes of the original survey.

ONTONAGON COUNTY

PEER APPROVED

*Earl W Applbaum  
Ont Co Rep.  
Jan 25, 1995*

C. Description of monument for corner and accessories established to perpetuate locating the position of the corner:

At the corner position I set a 2 1/2" diameter by 30" long aluminum monument with a 3 1/2" aluminum cap with magnet stamped to read: T.49N., R.43W.; 1/4; S-28, S-33; 1994; R.L.S. 21564 from which I established the following new blazed and scribed bearing trees and/or objects:

7"	Sugar Maple	N.10W.	12.39 feet
17"	Hemlock	S.20E.	40.34 feet
11"	Sugar Maple	S.54W.	26.32 feet
6'	Steel rail	S.46W.	1.73 feet



Signed by Richard L. Drahn

Date January 24, 1995

Surveyor's Michigan License No. 21564

USFS #V-11