

DEC 18 1996

COMMISSION

JUDITH D. ROEHM 07/11/96
Ontonagon County 08:54
LC 4/112 JEM Fee: 9.00
Page 1 of 1

LAND CORNER RECORDATION CERTIFICATE
Filing Requirement of Act 74, Mich. P.A. 1970

For corners in

<u>Ontonagon</u> <small>(County)</small>	Located In:	Corner Code #
1. Public Land Survey	T 49N R 43W	L-11
	T _____ R _____	_____
	T _____ R _____	_____
	T _____ R _____	_____
2. Property Controlling in Section	S _____ T _____ R _____	_____
	S _____ T _____ R _____	_____
3. Miscellaneous Property in Sec.	S _____ T _____ R _____	_____
	S _____ T _____ R _____	_____

Register of Deeds Stamp & File Number

- 4. Lot No. _____, Recorded Plat _____
- 5. Private Claims _____

1/4 Corner 25 & 36; T.49 N., R.43 W.

I, Richard L. Drahn in a field survey on June 4, _____, 19 96, do hereby certify that under requirements of P.A. 74, Michigan P.A. of 1970, the corner points mentioned in lines 1 and 2 above were in conformance with regulations and rules therefore as required in the current manual of survey instructions of the United States Department of the Interior, Bureau of Land Management or by a decree of a Court of Law and/or that the corner points mentioned in lines 3, 4 and 5 above were in conformance with the rules of the Michigan Board of Land Surveyors or by a Decree of a Court of Law; established, re-established, monumented, re-monumented, recovered, found as expressed below:

	A	B	C	D	E	F	G	H	I	J	K	L	M
2	6	5	4	3	2								
3													
4	7	8	9	10	11	12							
5													
7													
8	18	20	21	22	23	24							
9													
10	30	29	28	27	26	25							
11													
12	31	32	33	34	35	36							
13													

NOTE: Not more than 4 corners, all in the same town and range, may be recorded on this certificate.

- A. Description of original monument and accessories and/or subsequent restoration:
Corner established by William Burt on June 23, 1848. Original B.T.s --- Fir 12" N.80 W. 4 links (2.64') --- Sugar 14" S.65 E. 30 links (19.80')--- Corner re-established by Richard L. Drahn RLS 21564 on 5/16/88 by single proportionate methods. He set a 2 1/2" dia. aluminum pipe with a 3/4" stamped aluminum cap and the following new bearing objects: --- 6" (7") Sugar Maple N.62 W. (N.62 W.) 14.54' (14.54') --- 7" (9") White Ash N.20 E. (N.18 E.) 16.49' (16.48') --- 17" (19") Northern Red Oak S.29 W. (S.30 W.) 41.12' (41.10') --- 6' Steel sign rail S.06 E. (S.04 E.) 1.2' (1.2') --- Corner recorded in Ontonagon County in Liber 3, Page 91 on 5/8/89. Act 74 research form on file with Ontonagon County records.
- B. Description of corner evidence found and/or method applied in restoring or reestablishing corner:
Recovered the monument as described and the bearing objects as noted in parentheses above. No evidence remains of the original bearing trees.


PEER GROUP APPROVED

Earl W. Applekamp
COUNTY REPRESENTATIVE

- C. Description of monument for corner and accessories established to perpetuate locating the position of the corner: 07-08-96

New bearing tree referenced:

10" Sugar Maple N.60 E. 32.05'

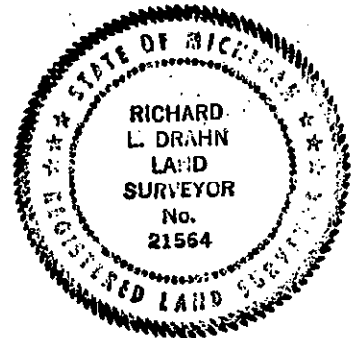

Signed by Richard L. Drahn

Date June 8, 1996

Surveyor's Michigan License No. 21564