

LAND CORNER RECORDATION CERTIFICATE
 Filing Requirement of Act 74, Mich. P.A. 1970

For corners in

<u>Ontonagon</u> (County)	Located In:	Corner Code #
1. Public Land Survey	T 50N R 38W	C-1
	T ___ R ___	_____
	T ___ R ___	_____
	T ___ R ___	_____
2. Property Controlling in Section	S ___ T ___ R ___	_____
	S ___ T ___ R ___	_____
3. Miscellaneous Property In Sec.	S ___ T ___ R ___	_____
	S ___ T ___ R ___	_____

SURVEY &
 REMONUMENTATION

APR 07 1998

SECTION

Register of Deeds Stamp & File Number

4. Lot No. _____, Recorded Plat _____
 5. Private Claims _____

I, Joseph C. Domitrovich, in a field survey on November 6, 19 97 do hereby state that under requirements of P.A. 74, Michigan P.A. of 1970, the corner points mentioned in lines 1 and 2 above were in conformance with regulations and rules therefore as required in the current manual of survey instructions of the United States Department of the Interior, Bureau of Land Management or by a decree of a Court of Law and/or that the corner points mentioned in lines 3, 4 and 5 above were in conformance with the rules of the Michigan Board of Land Surveyors or by a Decree of a Court of Law; established, re-established, monumented, recovered, found as expressed below:

NOTE: Not more than 2 corners, all in the same town and range, may be recorded on this certificate.

A	B	C	D	E	F	G	H	I	J	K	L	M
1												
2	6	5	4	3	2	1						
3												
4	7	8	9	10	11	12						
5												
6	18	17	16	15	14	13						
7												
8	19	20	21	22	23	24						
9												
10	30	29	28	27	26	25						
11												
12	31	32	33	34	35	36						
13												

(C-1) Closing Corner Common to Sections 6 & 5, T 50N, R 38W

A. Description of original monument and accessories and/or subsequent restoration:

1847 - Sylvester W. Higgins intersected the North boundary 13.40 chains (884.40 feet) West of the 1/4 post in Section 35, T 51N, R 38W, and set a post.

6" Hemlock S 20° W 15 links
 10" Sugar S 22° E 20 links

1899 - Chas. S. Butts, Surveyor, for the Plat of Mass City, shows the NW corner of Section 5 as the Point of Beginning, 879.5 feet West of a stone 1/4 post in Section 35, T 51N, R 38W. He indicates corner is a 1 1/2" iron rod.

1954 - Michigan State Highway Department, for M-26 Highway Construction plans, show 1 1/4" iron pipe at corner.
 Ties: 10" Maple N 12° E 36.10', 14" Maple N 54° E 71.60', 14" Maple S 31° W 16.25'
 Distance to SW Corner of Section 5 is shown as 4604.89 feet.

B. Description of corner evidence found and/or method applied in restoring or reestablishing corner:

Original corner and accessories were not recovered. I found a 2" diameter iron pipe with a 1 1/4" iron pin driven into it. I could find no remains of any of the M.S.H.D. bearing trees, but this pipe works well with the Plat distance East to the stone recovered at the South 1/4 Corner of Section 35, T 51N, R 38W and M.S.H.D. distance South to SW Corner Section 5.

Distance to: S 1/4 Corner Section 35 S 89° 44' 03" E 882.42' (meas.), 884.40 (GLO), 879.5' (Plat)
 SW Corner Section 5 S 00° 49' 36" W 4604.88 (meas.), 4601.5 (GLO), 4604.89 (M.S.H.D.)

I accepted the pipe as the best remaining evidence of the original Closing Corner and monumented it as such.

Research on file with County Remonumentation Representative.

C. Description of monument for corner and accessories established to perpetuate locating the position of the corner:


Corner is a 2" iron pipe with a 1 1/4" iron pin inside it. I drove a 2" x 30" aluminum Pipe with a 3" diameter cap firmly over the pipe and pin. The cap is stamped to read: COUNTY REMONUMENTATION; T.50N, R.38W; C.C.; S. 6, S. 5; 1997; P.S. 37273.

Witnesses:

7" Soft Maple N 75° W 3.66'
 9" Oak N 05° W 31.57'
 4" Oak N 70° E 12.84'
 Steel Sign Post South 1.04' (to face)

PEER GROUP APPROVED

Carl W. Applekamp
 COUNTY REPRESENTATIVE
 11-11-97

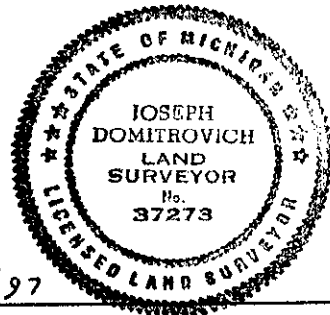

NOTE: Bearings are magnetic. Distances are to nail in side of witness objects unless noted.

Signed by Joseph C. Domitrovich
 Surveyor's Michigan License No. 37273

Date 11/10/97