

LAND CORNER RECORDATION CERTIFICATE
 Filing Requirement of Act 74, Mich. P.A. 1970

For corners in

<u>Ontonagon</u> (County)	Located In:	Corner Code #
1. Public Land Survey	T 50N R 38W	C-2
	T ___ R ___	_____
	T ___ R ___	_____
	T ___ R ___	_____
2. Property Controlling in Section	S ___ T ___ R ___	_____
	S ___ T ___ R ___	_____
3. Miscellaneous Property in Sec.	S ___ T ___ R ___	_____
	S ___ T ___ R ___	_____

SURVEY &
 REMONUMENTATION

APR 07 1998

SECTION

Register of Deeds Stamp & File Number

4. Lot No. _____, Recorded Plat _____
 5. Private Claims _____

1	A	B	C	D	E	F	G	H	I	J	K	L	M
2	6		5		4		3		2		1		
3													
4	7		8		9		10		11		12		
5													
6	18		17		16		15		14		13		
7													
8	19		20		21		22		23		24		
9													
10	30		29		28		27		26		25		
11													
12	31		32		33		34		35		36		
13													

I, Joseph C. Domitrovich, in a field survey on September 30, 1997 do hereby state that under requirements of P.A. 74, Michigan P.A. of 1970, the corner points mentioned in lines 1 and 2 above were in conformance with regulations and rules therefore as required in the current manual of survey instructions of the United States Department of the Interior, Bureau of Land Management or by a decree of a Court of Law and for that the corner points mentioned in lines 3, 4 and 5 above were in conformance with the rules of the Michigan Board of Land Surveyors or by a Decree of a Court of Law; established, re-established, monumented, recovered, found as expressed below:

NOTE: Not more than 2 corners, all in the same town and range, may be recorded on this certificate.

(C-2) 1/4 Corner Common to Sections 5 & 6, T 50N, R 38W

A. Description of original monument and accessories and/or subsequent restoration:

1847 - Sylvester W. Higgins set post
 8" Balsam N 85° W 3 links
 8" Y. Birch S 63° E 21 links

B. Description of corner evidence found and/or method applied in restoring or reestablishing corner:
 The original corner and accessories have been destroyed by logging.

I re-established the corner by single proportionate measurement. Distances North and South work well with original GLO.
 The corner falls in a grown over thorn apple thicket.

Research on file with County Remonumentation Representative.


C. Description of monument for corner and accessories established to perpetuate locating the position of the corner:

Corner is a 2" x 30" aluminum pipe with a 3" diameter aluminum cap stamped to read: COUNTY REMONUMENTATION; 1/4; S. 5, S. 6; T.50N, R.38W; 1997; P.S. 37273.

Witnesses:

2" Thorn Apple	N 42° E	19.53'	
6" Apple	East	26.38'	
Steel Sign Post	South	1.31'	(to face)
12" Spruce	N 71° W	33.12'	
SW Cor. Section 5	S 00° 49' 37" W	2638.09'	
NW Cor. Section 5	N 00° 49' 37" E	1966.80'	

PEER GROUP APPROVED
Earl W. Applekamp
 COUNTY REMONUMENTATION
 10-08-97

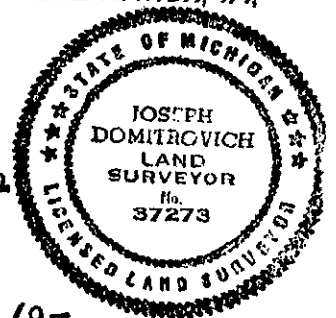

NOTE: Bearings are magnetic. Distances are to nail in side of witness objects unless noted.

Signed by J. C. Domitrovich

Date 10/8/97

Surveyor's Michigan License No. 37273