

LAND CORNER RECORDATION CERTIFICATE  
 Filing Requirement of Act 74, Mich. P.A. 1970

For corners in

<u>Ontonagon</u> (County)	Located In:	Corner Code #
1. Public Land Survey	T <u>50N</u> R <u>38W</u>	<u>C-4</u>
	T _____ R _____	_____
	T _____ R _____	_____
	T _____ R _____	_____
2. Property Controlling in Section	S _____ T _____ R _____	_____
	S _____ T _____ R _____	_____
3. Miscellaneous Property in Sec.	S _____ T _____ R _____	_____
	S _____ T _____ R _____	_____

SURVEY &  
 REMONUMENTATION  
 OCT 30 1997  
 COMMISSION

Register of Deeds Stamp & File Number

4. Lot No. \_\_\_\_\_, Recorded Plat \_\_\_\_\_  
 5. Private Claims \_\_\_\_\_

I, Joseph C. Domitrovich, in a field survey on September 12 19 97 do hereby state that under requirements of P.A. 74, Michigan P.A. of 1970, the corner points mentioned in lines 1 and 2 above were in conformance with regulations and rules therefore as required in the current manual of survey instructions of the United States Department of the Interior, Bureau of Land Management or by a decree of a Court of Law and /or that the corner points mentioned in lines 3, 4 and 5 above were in conformance with the rules of the Michigan Board of Land Surveyors or by a Decree of a Court of Law, established, re-established, monumented, recovered, found as expressed below:

NOTE: Not more than 2 corners, all in the same town and range, may be recorded on this certificate.

A	B	C	D	E	F	G	H	I	J	K	L	M
1												
2	6		5		4		3		2		1	
3												
4	7	●	8		9		10		11		12	
5												
6	18		17		16		15		14		13	
7												
8	19		20		21		22		23		24	
9												
10	30		29		28		27		26		25	
11												
12	31		32		33		34		35		36	
13												

(C-4) 1/4 Corner Common to Section 7 & 8, T50N, R38W

A. Description of original monument and accessories and/or subsequent restoration:

1847 - Sylvester W. Higgins set post.  
 10" Sugar N 07° E 16 links  
 12" Lynn S 40° W 20 links

B. Description of corner evidence found and/or method applied in restoring or reestablishing corner:

I could find no remains of the original corner or accessories. At the corner position, I found a 1/2" x 18" iron bar at a fence intersection. It falls 50.8 feet East and 5.1 feet North of a single prorated position. The iron bar has been the long accepted corner. 1/16 fences have been built, using it as well as an old county road to the South. I believe it best represents the position of the original corner and have accepted it.

Research on file with County Remonumentation Representative.

C. Description of monument for corner and accessories established to perpetuate locating the position of the corner:

Corner is a 2" x 30" aluminum pipe with a 3" diameter aluminum cap stamped to read: COUNTY REMONUMENTATION; 1/4; T.50N, R.38W; S. 7, S. 8; 1997; P.S. 37273. Corner falls at the Northeast corner of a field at the intersection of fences West and South.


Witnesses:

10" Ash	N 52° E	15.23'	
3" Ironwood	N 85° E	6.29'	
7" Basswood	S 26° W	2.63'	
6" Ash	N 73° W	11.41'	
Steel Sign Post	North	1.03'	(to face)

PEER GROUP APPROVED

Earl W. Appleton  
 COUNTY REPRESENTATIVE

9-17-97

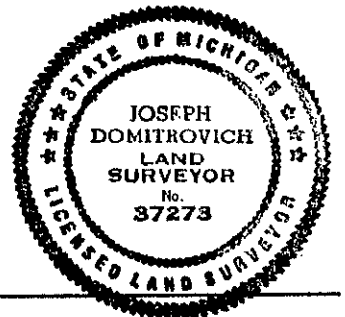

NOTE: Bearings are magnetic. Distances are to nail in side of witness objects unless noted.

Signed by J.C. Domitrovich  
 Surveyor's Michigan License No. 37273

Date 9/16/97