

LAND CORNER RECORDATION CERTIFICATE
 Filing Requirement of Act 74, Mich. P.A. 1970

For corners in

<u>Ontonagon</u> (County)	Located In:	Corner Code #
1. Public Land Survey	T <u>50NR</u> R <u>38W</u>	<u>D-3</u>
	T _____ R _____	_____
	T _____ R _____	_____
	T _____ R _____	_____
2. Property Controlling in Section	S _____ T _____ R _____	_____
	S _____ T _____ R _____	_____
3. Miscellaneous Property in Sec.	S _____ T _____ R _____	_____
	S _____ T _____ R _____	_____

**SURVEY &
 REMONUMENTATION**

APR 07 1998

SECTION

Register of Deeds Stamp & File Number

4. Lot No. _____, Recorded Plat _____
 5. Private Claims _____

I, Joseph C. Domitrovich, in a field survey on November 7, 19 97 do hereby state that under requirements of P.A. 74, Michigan P.A. of 1970, the corner points mentioned in lines 1 and 2 above were in conformance with regulations and rules therefore as required in the current manual of survey instructions of the United States Department of the Interior, Bureau of Land Management or by a decree of a Court of Law and/or that the corner points mentioned in lines 3, 4 and 5 above were in conformance with the rules of the Michigan Board of Land Surveyors or by a Decree of a Court of Law; established, re-established, monumented, recovered, found as expressed below:

NOTE: Not more than 2 corners, all in the same town and range, may be recorded on this certificate.

(D-3) 1/4 Corner Common to Sections 5 & 8, T 50N, R 38W

A. Description of original monument and accessories and/or subsequent restoration:

1847 - Sylvester W. Higgins set post
 12" Sugar N 15° W 17 links
 10" Sugar S 10° E 15 links

B. Description of corner evidence found and/or method applied in restoring or reestablishing corner:

Original corner and accessories were not recovered. A forester's East-West orange painted line runs East and West in area apparently indicating the Section line. There is no evidence of the 1/4 corner. I re-established the corner by single proportionate measurement. This falls 24 feet South of the orange painted line and 26 feet South of a curve in an Easterly-Westerly logging road.

Research on file with County Remonumentation Representative.


C. Description of monument for corner and accessories established to perpetuate locating the position of the corner:

Corner is a 2" x 30" aluminum pipe with a 3" diameter aluminum cap stamped to read: COUNTY REMONUMENTATION; T.50N, R.38W; 1/4; S. 5, S. 8; 1997; P.S. 37273.

Witnesses:

4" Ironwood	S 86° E	8.87'
6" Hard Maple	S 07° E	19.71'
3" Hard Maple	S 55° W	16.88'
6" Hard Maple	N 75° W	10.23'
Steel Sign post	North	0.90' (to face)
NE Cor. Section 8	S 89° 01' 39" W	2679.32'
NW Cor. Section 8	N 89° 01' 39" E	2679.32'

PEER GROUP APPROVED
Earl W. Applekamp
 COUNTY REPRESENTATIVE
 11-11-97

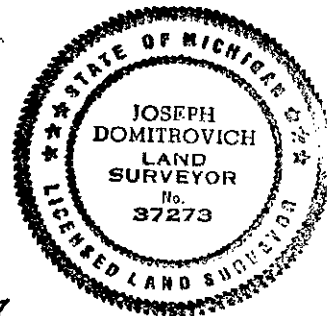

NOTE: Bearings are magnetic. Distances are to nail in side of witness objects unless noted.

Signed by J. C. Domitrovich
 Surveyor's Michigan License No. 37273

Date 11/10/97