

LAND CORNER RECORDATION CERTIFICATE
 Filing Requirement of Act 74, Mich. P.A. 1970

For corners in

<u>Ontonagon</u> (County)	Located In:	Corner Code #
1. Public Land Survey	T <u>50N</u> R <u>38W</u>	<u>D-5</u>
	T ___ R ___	_____
	T ___ R ___	_____
	T ___ R ___	_____
2. Property Controlling in Section	S ___ T ___ R ___	_____
	S ___ T ___ R ___	_____
3. Miscellaneous Property in Sec.	S ___ T ___ R ___	_____
	S ___ T ___ R ___	_____

QUIVET &
 REMONUMENTATION

OCT 30 1997

COMMISSION

Register of Deeds Stamp & File Number

4. Lot No. _____, Recorded Plat _____
 5. Private Claims _____

I, Joseph C. Domitrovich, in a field survey on August 29, 19 97 do hereby state that under requirements of P.A. 74, Michigan P.A. of 1970, the corner points mentioned in lines 1 and 2 above were in conformance with regulations and rules therefore as required in the current manual of survey instructions of the United States Department of the Interior, Bureau of Land Management or by a decree of a Court of Law and /or that the corner points mentioned in lines 3, 4 and 5 above were in conformance with the rules of the Michigan Board of Land Surveyors or by a Decree of a Court of Law; established, re-established, monumented, recovered, found as expressed below:

NOTE: Not more than 2 corners, all in the same town and range, may be recorded on this certificate.

A	B	C	D	E	F	G	H	I	J	K	L	M
1												
2	6		5		4		3		2		1	
3												
4	7		8		9		10		11		12	
5			●									
6	18		17		16		15		14		13	
7												
8	19		20		21		22		23		24	
9												
10	30		29		28		27		26		25	
11												
12	31		32		33		34		35		36	
13												

(D-5) 1/4 Corner Common to Sections 8 & 17, T 50 N, R 38W

A. Description of original monument and accessories and/or subsequent restoration:

1847 - Sylvester W. Higgins set post
 18" Sugar S 43° E 8 links
 14" Hemlock N 20° W 23 links

B. Description of corner evidence found and/or method applied in restoring or reestablishing corner:

The original corner and accessories have been destroyed by farming and road construction. At the corner, I found a 1" square iron pin 18" below the gravel surface of Riikonen Road. It is 3 feet South of centerline and on the extension of an old fence line to the South. This pin falls 75.3' off a prorated position, but it has obviously been used to establish 1/16 fences to the East and West, as well as to cut out a one acre parcel to the West. There is no record of where this pin came from, but it has obviously been the accepted 1/4 corner for many years. Considering other measurements of original GLO work in this township, the location of this pin is not inconsistent with where the original surveyor would have placed the corner. I accepted the square iron pin as the 1/4 corner and raised it up with a 5/8" iron pin.


Research on file with County Remonumentation Representative.

C. Description of monument for corner and accessories established to perpetuate locating the position of the corner:

Corner is a 5/8" x 24" iron pin with a 3" diameter aluminum cap stamped to read: COUNTY REMONUMENTATION; 1/4; S.8, S. 17; T. 50 N, R.38 W; 1997; P.S. 37273. I also established a reference monument (R.M.) to the South, a 2" diameter aluminum pipe with a 3" diameter aluminum cap stamped to indicate that the 1/4 corner is North 22.10'.

Power Pole	S 41° W	39.77'
8" Poplar	N 30° W	75.12'
3" Soft Maple	N 23° E	53.10'
R.M.	S 00° 25' 04" E	22.10'
SW Cor. Section 8	N 89° 10' 23" W	2604.81'
SE Cor. Section 8	N 88° 34' 21" E	2454.12'

BEER GROUP APPROVED
Earl W. Applikamp
 COUNTY REPRESENTATIVE
 9-17-97

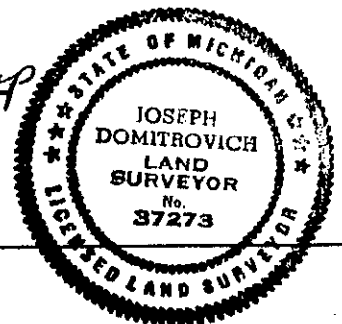

NOTE: Bearings are magnetic. Distances are to nail in side of witness objects unless noted.

Signed by Joseph C. Domitrovich Date 9/16/97
 Surveyor's Michigan License No. 37273