


LAND CORNER RECORDATION CERTIFICATE
 Filing Requirement of Act 74, Mich. P.A. 1970

For corners in

<u>Ontonagon</u> (County)	Located In:	Corner Code #
1. Public Land Survey	T <u>50N</u> R <u>38W</u>	<u>E-1</u>
	T ___ R ___	_____
	T ___ R ___	_____
	T ___ R ___	_____
2. Property Controlling in Section	S ___ T ___ R ___	_____
	S ___ T ___ R ___	_____
3. Miscellaneous Property in Sec.	S ___ T ___ R ___	_____
	S ___ T ___ R ___	_____

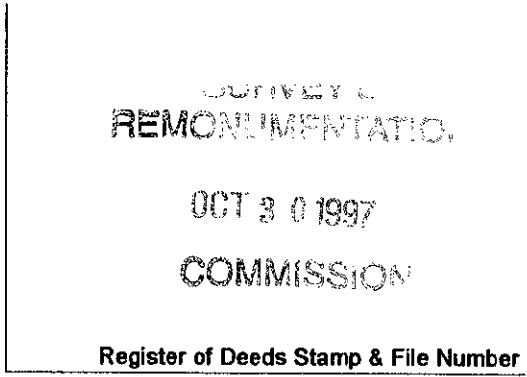

4. Lot No. _____, Recorded Plat _____
 5. Private Claims _____

I, Joseph C. Domitrovich, in a field survey on August 7, 19 97 do hereby state that under requirements of P.A. 74, Michigan P.A. of 1970, the corner points mentioned in lines 1 and 2 above were in conformance with regulations and rules therefore as required in the current manual of survey instructions of the United States Department of the Interior, Bureau of Land Management or by a decree of a Court of Law and /or that the corner points mentioned in lines 3, 4 and 5 above were in conformance with the rules of the Michigan Board of Land Surveyors or by a Decree of a Court of Law; established, re-established, monumented, recovered, found as expressed below:

NOTE: Not more than 2 corners, all in the same town and range, may be recorded on this certificate.

	A	B	C	D	E	F	G	H	I	J	K	L	M
1													
2		6		5		4		3		2		1	
3													
4		7		8		9		10		11		12	
5													
6		18		17		16		15		14		13	
7													
8		19		20		21		22		23		24	
9													
10		30		29		28		27		26		25	
11													
12		31		32		33		34		35		36	
13													

E-1 Closing Corner of Sections 4 & 5, T50N, R38W

A. Description of original monument and accessories and/or subsequent restoration:

- 1847** - Sylvester Higgins, D.S., intersected the 5th Correction line 13.75 chains (907.50') West of the 1/4 post in Section 36, T 51N, R 38W and set post.
 10" Hemlock S 60° E 12 links
 20" Hemlock S 25° W 26 links
- 1954** - Michigan State Highway Department, for M-26 Highway Construction Plans, found a 2" iron pipe.
 Ties:
 12" Elm N 50° E 27.90'
 8" Twin Birch S 50° E 35.30'
 5" Maple S 36° W 25.50'

B. Description of corner evidence found and/or method applied in restoring or reestablishing corner:

Original corner and accessories have been destroyed by road construction and logging. I found a 3" O.D. iron pipe in old road bed running East-West, on extension of old fenceline to South. I recovered the 3 M.S.H.D. bearing trees. (The elm is now fallen.) I also found a newer 1 1/4" galvanized pipe in the fenceline 23.03 feet to the South. Some unknown person blazed trees facing the galvanized pipe. M.S.H.D. bearings and distances work well with the 3" iron pipe in road bed. This pipe also works well with the Closing and Standard Corners to the East and West.

I, therefore, accepted the 3" pipe in the road bed as the Closing Corner.

Research on file with County Remonumentation Representative.

DEER GROUP APPROVED
Earl W. Applkamp
 COUNTY REMONUMENTATION 8-13-97

C. Description of monument for corner and accessories established to perpetuate locating the position of the corner:

Corner is a 3/4" x 36" aluminum rod driven into 3" iron pipe, capped with a 3" diameter aluminum cap stamped to read: COUNTY REMONUMENTATION; C.C.; S. 5, S. 4; T.50N, R.38W; 1997; P.S. 37273.

Witnesses:

12" Twin Y. Birch	S 46° E	35.23'	(M.S.H.D.)
Top of 1 1/4" Galv. Pipe	S 02° E	23.03'	
10" Soft Maple	S 38° W	25.40'	(M.S.H.D.)
8" Black Cherry	N 10° W	26.60'	
Steel Sign Post	North	1.59'	(to face)
SW Cor. Sec. 36, T51N, R38W	N 89° 19' 28" W	1722.54'	
S 1/4 Cor. Sec. 36, T51N, R38W	S 89° 19' 28" W	923.52'	

NOTE: Bearings are magnetic. Distances are to nail in side of witness objects unless noted.

Signed by J. C. Domitrovich
 Surveyor's Michigan License No. 37273

Date 8/13/97

