

LAND CORNER RECORDATION CERTIFICATE
 Filing Requirement of Act 74, Mich. P.A. 1970

For corners in

<u>Ontonagon</u> (County)	Located In:	Corner Code #
1. Public Land Survey	T <u>50N</u> R <u>38W</u>	<u>E-2</u>
	T <u> </u> R <u> </u>	<u> </u>
	T <u> </u> R <u> </u>	<u> </u>
	T <u> </u> R <u> </u>	<u> </u>
2. Property Controlling in Section	S <u> </u> T <u> </u> R <u> </u>	<u> </u>
	S <u> </u> T <u> </u> R <u> </u>	<u> </u>
3. Miscellaneous Property in Sec.	S <u> </u> T <u> </u> R <u> </u>	<u> </u>
	S <u> </u> T <u> </u> R <u> </u>	<u> </u>

SURVEY & REMONUMENTATION

APR 07 1998

SECTION

Register of Deeds Stamp & File Number

4. Lot No. _____, Recorded Plat _____
 5. Private Claims _____

I, Joseph C. Domitrovich, in a field survey on October 17, 19 97 do hereby state that under requirements of P.A. 74, Michigan P.A. of 1970, the corner points mentioned in lines 1 and 2 above were in conformance with regulations and rules therefore as required in the current manual of survey instructions of the United States Department of the Interior, Bureau of Land Management or by a decree of a Court of Law and/or that the corner points mentioned in lines 3, 4 and 5 above were in conformance with the rules of the Michigan Board of Land Surveyors or by a Decree of a Court of Law; established, re-established, monumented, recovered, found as expressed below:

NOTE: Not more than 2 corners, all in the same town and range, may be recorded on this certificate.

(E-2) 1/4 Corner Common to Sections 4 & 5, T50N, R38W

A	B	C	D	E	F	G	H	I	J	K	L	M
1												
2	6		5	●	4		3		2		1	
3												
4	7		8		9		10		11		12	
5												
6	18		17		16		15		14		13	
7												
8	19		20		21		22		23		24	
9												
10	30		29		28		27		26		25	
11												
12	31		32		33		34		35		36	
13												

A. Description of original monument and accessories and/or subsequent restoration:

1847 - Sylvester W. Higgins set post
 12" Balsam S 44° E 19 links
 9" Y. Birch N 50° W 14 links

B. Description of corner evidence found and/or method applied in restoring or reestablishing corner:

The original post and accessories were not recovered. An old fence now runs North and West from corner. The intersection of fencelines falls 3 feet North and 29.5' East of a computed single prorated position. This is not inconsistent with other work done by Higgins in this township. I accepted the intersection of fencelines as the best remaining evidence of the original corner and have monumented it as the 1/4 corner.

Research on file with County Remonumentation Representative.


C. Description of monument for corner and accessories established to perpetuate locating the position of the corner:

Corner is a 2" x 30" aluminum pipe with a 3" diameter aluminum cap stamped to read: COUNTY REMONUMENTATION; T.50N, R.38W; 1/4; S. 5, S. 4; 1997; P.S. 37273.

Witnesses:

6" Cedar	N 58° E	8.93'
6" Cedar	S 50° E	21.93'
8" Soft Maple	S 05° E	17.98'
9" Ash	S 48° W	11.31'
Steel Sign Post	North	0.79' (to face)
NE Cor. Section 5	N 01° 27' 58" W	1876.40'
SE Cor. Section 5	S 00° 04' 50" W	2624.02'

PEER GROUP APPROVED
Earl W. Appleby
 COUNTY REPRESENTATIVE
 11-11-97

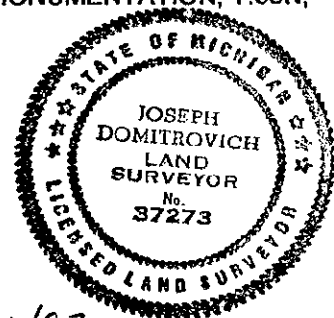

NOTE: Bearings are magnetic. Distances are to nail in side of witness objects unless noted.

Signed by Joseph C. Domitrovich Date 11/10/97
 Surveyor's Michigan License No. 37273