

LAND CORNER RECORDATION CERTIFICATE  
 Filing Requirement of Act 74, Mich. P.A. 1970

For corners in

<u>Ontonagon</u> (County)	Located In:	Corner Code #
1. Public Land Survey	T <u>50N</u> R <u>38W</u>	<u>E-3</u>
	T _____ R _____	_____
	T _____ R _____	_____
	T _____ R _____	_____
2. Property Controlling in Section	S _____ T _____ R _____	_____
	S _____ T _____ R _____	_____
3. Miscellaneous Property in Sec.	S _____ T _____ R _____	_____
	S _____ T _____ R _____	_____

SURVEY &  
 REMONUMENTATION

OCT 30 1997

COMMISSION

Register of Deeds Stamp & File Number

4. Lot No. \_\_\_\_\_, Recorded Plat \_\_\_\_\_  
 5. Private Claims \_\_\_\_\_

I, Joseph C. Domitrovich, in a field survey on September 12 19 97 do hereby state that under requirements of P.A. 74, Michigan P.A. of 1970, the corner points mentioned in lines 1 and 2 above were in conformance with regulations and rules therefore as required in the current manual of survey instructions of the United States Department of the Interior, Bureau of Land Management or by a decree of a Court of Law and /or that the corner points mentioned in lines 3, 4 and 5 above were in conformance with the rules of the Michigan Board of Land Surveyors or by a Decree of a Court of Law; established, re-established, monumented, recovered, found as expressed below:

NOTE: Not more than 2 corners, all in the same town and range, may be recorded on this certificate.

	A	B	C	D	E	F	G	H	I	J	K	L	M
1													
2		6		5		4		3		2		1	
3					●								
4		7		8		9		10		11		12	
5													
6		16		17		16		15		14		13	
7													
8		19		20		21		22		23		24	
9													
10		30		29		28		27		26		25	
11													
12		31		32		33		34		35		36	
13													

(E-3) Corner Common to Sections 4, 5, 8 & 9, T50N, R38W

A. Description of original monument and accessories and/or subsequent restoration:

1847 - Sylvester W. Higgins set post.  
 20" Elm N 54° W 13 links  
 12" Spruce S 72° E 20 links

1899 - Plat of Mass City, on file at the Ontonagon County Register of Deeds, shows this corner, but does not give distances to it.

B. Description of corner evidence found and/or method applied in restoring or reestablishing corner:

I found no remains of original corner or accessories. I found a bent 1 1/2" pipe 12" below gravel surface, in approximate centerline of an East-West county road. It falls on the extension of a very old fallen fence to the South. This pipe is N 48° W 46 feet from a double prorated position. It is, however, the long accepted corner, and I believe it best represents the original GLO corner position. I have accepted the pipe as the 1/4 corner and raised it up with a 5/8" x 24" iron pin.

Research on file with County Remonumentation Representative.

C. Description of monument for corner and accessories established to perpetuate locating the position of the corner:

Corner is a 5/8" x 24" iron pin with a 3" diameter aluminum cap stamped to read: COUNTY REMONUMENTATION; S. 4, S. 5, S. 8, S. 9; T.50N, R.38W; 1997; P.S. 37273. I also established a reference monument (R.M.) to the South, a 2" x 30" aluminum pipe with a 3" diameter aluminum cap stamped to indicate that the Section corner is North 27.17 feet.

Witnesses:


Power Pole	S 58° W	59.42'
10" Spruce	N 07° W	31.32'
17" Poplar	N 59° E	40.38'
R.M.	S 00° 27' 07" W	27.17'
E 1/4 Cor. Section 8	S 00° 23' 38" W	2669.50'
Closing Cor. Sec. 4 & 5	N 00° 33' 51" W	4500.02'

PEER GROUP APPROVED

*Earl W. Applekamp*  
 COUNTY REPRESENTATIVE

9-17-97

Date 9/16/97

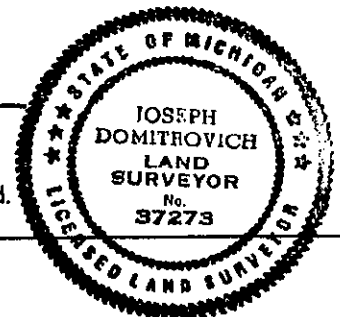

NOTE: Bearings are magnetic. Distances are to nail in side of witness objects unless noted.

Signed by J. C. Domitrovich  
 Surveyor's Michigan License No. 37273