

**LAND CORNER RECORDATION CERTIFICATE**  
 Filing Requirement of Act 74, Mich. P.A. 1970

For corners in

<u>Ontonagon</u> (County)	Located In:	Corner Code #
1. Public Land Survey	T <u>50N</u> R <u>38W</u>	<u>E-4</u>
	T ___ R ___	_____
	T ___ R ___	_____
	T ___ R ___	_____
2. Property Controlling in Section	S ___ T ___ R ___	_____
	S ___ T ___ R ___	_____
3. Miscellaneous Property in Sec.	S ___ T ___ R ___	_____
	S ___ T ___ R ___	_____

SURVEY &  
**REMONUMENTATION**

OCT 30 1997

**COMMISSION**

Register of Deeds Stamp & File Number

4. Lot No. \_\_\_\_\_, Recorded Plat \_\_\_\_\_  
 5. Private Claims \_\_\_\_\_

I, Joseph C. Domitrovich, in a field survey on September 12, 1997 do hereby state that under requirements of P.A. 74, Michigan P.A. of 1970, the corner points mentioned in lines 1 and 2 above were in conformance with regulations and rules therefore as required in the current manual of survey instructions of the United States Department of the Interior, Bureau of Land Management or by a decree of a Court of Law and /or that the corner points mentioned in lines 3, 4 and 5 above were in conformance with the rules of the Michigan Board of Land Surveyors or by a Decree of a Court of Law; established, re-established, monumented, recovered, found as expressed below:

NOTE: Not more than 2 corners, all in the same town and range, may be recorded on this certificate.

**(E-4) 1/4 Corner Common of Sections 8 & 9, T50N, R38W**

A. Description of original monument and accessories and/or subsequent restoration:

- 1847 - Sylvester W. Higgins set post
  - 12" Hemlock S 35° E 18 links
  - 12" Balsam N 50° W 13 links

B. Description of corner evidence found and/or method applied in restoring or reestablishing corner:

Original corner and accessories have been destroyed by road construction and farming. At the corner, I found North-South East Branch Road and a fallen fence to the East. I created a position for the 1/4 corner at the intersection of centerline of East Branch Road and the extension of the fence to the East. This position is 13.2' South and 7.9' West of where a single prorated position would fall. The road and fence intersection, however, has been the long accepted 1/4 corner position. Therefore, I monumented it as the 1/4 corner.

Research on file with County Remonumentation Representative.

C. Description of monument for corner and accessories established to perpetuate locating the position of the corner:

Corner is a 5/8" iron pin with a 3" diameter aluminum cap stamped to read: COUNTY REMONUMENTATION; 1/4; S.8, S. 9; T. 50N, R. 38W; 1997; P.S. 37273. I also established a reference monument (R.M.) to the West, a 2" x 30" aluminum pipe with a 3" diameter aluminum cap stamped to indicate that the 1/4 corner is East 28.54'. Corner falls in the centerline of the North-South paved East Branch Road.

7" Poplar	N 52° E	44.69'
10" Poplar	N 89° E	28.20'
Power Pole	S 60° W	56.00'
R.M.	N 89° 55' 24" W	28.54'
SE Cor. Section 8	S 00° 03' 05" W	2643.14'
NE Cor. Section 8	N 00° 23' 38" E	2669.50'


NOTE: Bearings are magnetic. Distances are to nail in side of witness objects unless noted.

Signed by J. C. Domitrovich

Date 9/16/97

Surveyor's Michigan License No. 37273

**PEER GROUP APPROVED**  
*Earl W. Applekamp*  
 COUNTY REMONUMENTATION  
 9-17-97

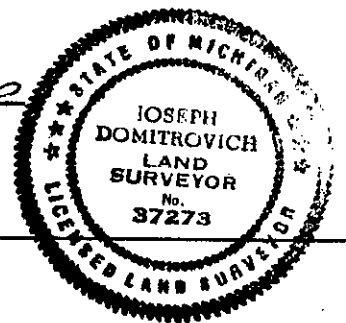

	A	B	C	D	E	F	G	H	I	J	K	L	M
1													
2	6		5		4		3		2		1		
3													
4	7		8		9		10		11		12		
5													
6	10		17		16		15		14		13		
7													
8	19		20		21		22		23		24		
9													
10	30		29		28		27		26		25		
11													
12	31		32		33		34		35		36		
13													