

LAND CORNER RECORDATION CERTIFICATE
Filing Requirement of Act 74, Mich. P.A. 1970

For corners in

<u>Ontonagon</u> (County)	Located In:	Corner Code #
1. Public Land Survey	T <u>50N</u> R <u>38W</u>	<u>E-5</u>
	T ___ R ___	_____
	T ___ R ___	_____
	T ___ R ___	_____
2. Property Controlling in Section	S ___ T ___ R ___	_____
	S ___ T ___ R ___	_____
3. Miscellaneous Property in Sec.	S ___ T ___ R ___	_____
	S ___ T ___ R ___	_____

SURVEY &
 REMONUMENTATION

OCT 30 1997

COMMISSION

Register of Deeds Stamp & File Number

4. Lot No. _____, Recorded Plat _____
 5. Private Claims _____

I, Joseph C. Domitrovich, in a field survey on September 12, 19 97 do hereby state that under requirements of P.A. 74, Michigan P.A. of 1970, the corner points mentioned in lines 1 and 2 above were in conformance with regulations and rules therefore as required in the current manual of survey instructions of the United States Department of the Interior, Bureau of Land Management or by a decree of a Court of Law and /or that the corner points mentioned in lines 3, 4 and 5 above were in conformance with the rules of the Michigan Board of Land Surveyors or by a Decree of a Court of Law; established, re-established, monumented, recovered, found as expressed below:

NOTE: Not more than 2 corners, all in the same town and range, may be recorded on this certificate.

A	B	C	D	E	F	G	H	I	J	K	L	M
1												
2	6		5		4		3		2		1	
3												
4	7		8		9		10		11		12	
5												
6	10		17		16		15		14		13	
7												
8	19		20		21		22		23		24	
9												
10	30		29		28		27		26		25	
11												
12	31		32		33		34		35		36	
13												

(E-5) Corner of Sections 8, 9, 16 & 17, T50N, R38W

A. Description of original monument and accessories and/or subsequent restoration:

1847 - Sylvester W. Higgins set post.
 8" Balsam N 56° W 25 links
 10" Y. Birch S 20° E 9 links

1980 - Ontonagon County Road Commission, in East Branch Road Construction plans (on file at Ontonagon County Road Commission Office), calls for a 18" 'tee' iron at the corner at the intersection of centerlines North, South, and West.
 Ties: Corner Fence Post N 45° W 45.10'
 Fence Post N 45° E 40.05'
 Cor. Fence Post S 45° W 45.85'

B. Description of corner evidence found and/or method applied in restoring or reestablishing corner:

The original corner and accessories have been destroyed by road construction and farming. I also found no remains of the Road Commission corner. At the corner is North-South paved East Branch Road and gravel Riikonen Road to the West. I created a position for the section corner at the intersection of centerlines of said roads. This position is 162' +/- West of a double prorated position. This is because of large discrepancies in distances with GLO to the East and West. I believe this the result of either error or fraudulent work in the original survey. The position of the intersection of centerlines has been the long accepted Section Corner. I believe it best represents the position of the original corner. Therefore, I have accepted and monumented it as such.

Research on file with County Remonumentation Representative.


C. Description of monument for corner and accessories established to perpetuate locating the position of the corner:

Corner is a 5/8" x 24" iron pin with a 3" diameter aluminum cap stamped to read: COUNTY REMONUMENTATION; T.50N, R.38W; S. 8, S. 9, S. 16, S. 17; 1997; P.S. 37273. I also established a reference monument (R.M.) to the East, a 2" x 30" aluminum pipe, with a 3" diameter aluminum cap stamped to indicate that the Section Corner is West 34.33 feet.

Power Pole	S 48° E	52.25'
Power Pole	S 52° W	49.76'
Power Pole	N 13° W	170.28'
R.M.	S 85° 47' 24" E	34.33'
S 1/4 Cor. Section 9	S 88° 34' 21" W	2454.12'
SE Cor. Section 9	S 89° 18' 40" E	5391.05'
E 1/4 Cor. Section 8	N 00° 03' 05" E	2643.14'

PEER GROUP APPROVED

Earl W. Applekamp
 COUNTY REPRESENTATIVE
 9-17-97

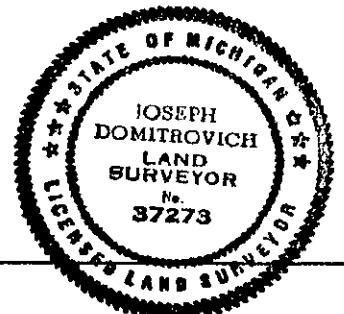

NOTE: Bearings are magnetic. Distances are to nail in side of witness objects unless noted.

Signed by Joseph C. Domitrovich Date 9/16/97

Surveyor's Michigan License No. 37273