


LAND CORNER RECORDATION CERTIFICATE
 Filing Requirement of Act 74, Mich. P.A. 1970

For corners in

<u>Ontonagon</u> (County)	Located In:	Corner Code #
1. Public Land Survey	T <u>50N</u> R <u>38W</u>	<u>F-1</u>
	T ___ R ___	_____
	T ___ R ___	_____
	T ___ R ___	_____
2. Property Controlling in Section	S ___ T ___ R ___	_____
	S ___ T ___ R ___	_____
3. Miscellaneous Property in Sec.	S ___ T ___ R ___	_____
	S ___ T ___ R ___	_____

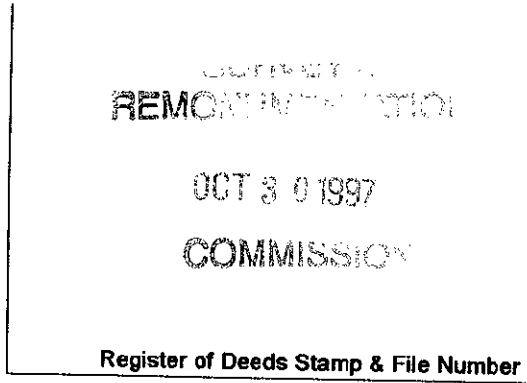

4. Lot No. _____, Recorded Plat _____
 5. Private Claims _____

I, Joseph C. Domitrovich, in a field survey on August 7, 19 97 do hereby state that under requirements of P.A. 74, Michigan P.A. of 1970, the corner points mentioned in lines 1 and 2 above were in conformance with regulations and rules therefore as required in the current manual of survey instructions of the United States Department of the Interior, Bureau of Land Management or by a decree of a Court of Law and /or that the corner points mentioned in lines 3, 4 and 5 above were in conformance with the rules of the Michigan Board of Land Surveyors or by a Decree of a Court of Law; established, re-established, monumented, recovered, found as expressed below:

NOTE: Not more than 2 corners, all in the same town and range, may be recorded on this certificate.

A	B	C	D	E	F	G	H	I	J	K	L	M
1												
2	6		5		4		3		2		1	
3												
4	7		8		9		10		11		12	
5												
6	18		17		16		15		14		13	
7												
8	19		20		21		22		23		24	
9												
10	30		29		28		27		26		25	
11												
12	31		32		33		34		35		36	
13												

(F-1) North 1/4 Corner of Section 4, T50N, R 38W

A. Description of original monument and accessories and/or subsequent restoration:

This corner was not set in the original survey. It falls on the 5th Correction line. Closing corners were set to the East and West by Sylvester Higgins, D.S., in 1847. Standard corners were set to the East and West by Austin Burt, D.S., in 1845.

B. Description of corner evidence found and/or method applied in restoring or reestablishing corner:

I found an East-West old road bed at the corner position. I found no other evidence of the corner position. I re-established the corner midway between Closing corners and on line between the South 1/4 corner and the Southwest corner of Section 36, T51N, R38W. Corner falls in the middle of the old East-West road bed.

PEER GROUP APPROVED
Carl W. Gopalkamp
 COUNTY REPRESENTATIVE 8-13-97


Research on file with County Remonumentation Representative.

C. Description of monument for corner and accessories established to perpetuate locating the position of the corner:

Corner is a 2" x 30" aluminum pipe with a 3" diameter aluminum cap stamped to read: COUNTY REMONUMENTATION; 1/4; S.4; C.C.; T.50N, R.38W; 1997; P.S. 37273.

Witnesses:

6" Soft Maple	S 10° E	17.40'	
7" Soft Maple	S 44° W	17.15'	
12" Oak	N 58° W	28.90'	
Steel Sign Post	North	1.14'	(to face)
S 1/4 Cor. Sec. 36	S 89° 52' 22" W	1801.65'	
SE Cor. Sec. 36	N 89° 52' 22" E	844.41'	

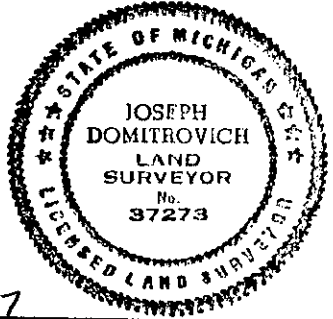

NOTE: Bearings are magnetic. Distances are to nail in side of witness objects unless noted.

Signed by J. C. Domitrovich Date 8/13/97
 Surveyor's Michigan License No. 37273