

LAND CORNER RECORDATION CERTIFICATE
 Filing Requirement of Act 74, Mich. P.A. 1970

For corners in

Ontonagon
 (County)


Located in: Corner Code #

- | | | |
|------------------------------------|------------|-----|
| 1. Public Land Survey | T 50NR 38W | H-5 |
| | T R | |
| | T R | |
| | T R | |
| 2. Property Controlling in Section | S T R | |
| | S T R | |
| 3. Miscellaneous Property in Sec. | S T R | |
| | S T R | |

REMONUMENTATION
 OCT 30 1997
 COMMISSION
 Register of Deeds Stamp & File Number

4. Lot No. _____, Recorded Plat _____
 5. Private Claims _____

I, Joseph C. Domitrovich, in a field survey on August 11, 19 97 do hereby state that under requirements of P.A. 74, Michigan P.A. of 1970, the corner points mentioned in lines 1 and 2 above were in conformance with regulations and rules therefore as required in the current manual of survey instructions of the United States Department of the Interior, Bureau of Land Management or by a decree of a Court of Law and for that the corner points mentioned in lines 3, 4 and 5 above were in conformance with the rules of the Michigan Board of Land Surveyors or by a Decree of a Court of Law; established, re-established, monumented, recovered, found as expressed below:

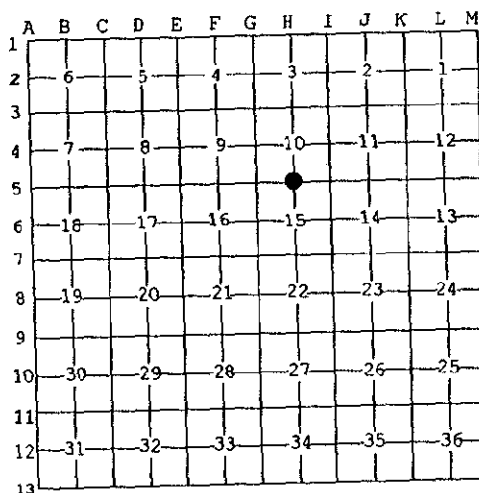

NOTE: Not more than 2 corners, all in the same town and range, may be recorded on this certificate.

(H-5) 1/4 Corner Common to Sections 10 & 15, T50N, R38W

A. Description of original monument and accessories and/or subsequent restoration:

- 1847 - Sylvester Higgins, D.S., set 1/4 post.
 20" Sugar S 52° E 30 links
 8" Ironwood N 23° E 14 links

B. Description of corner evidence found and/or method applied in restoring or reestablishing corner:

Original corner and accessories have been destroyed by farming and road construction. I found an old East-West road bed and a fence to the North, at the corner. I recreated the corner position at the intersection of centerline of the road bed and the extension of the fenceline. This falls within 1.03 feet of a split of the distance between Section corners and 17.6 feet North of a line between them.

I believe this position best represents the position of the original corner and have monumented it as such.

PEER GROUP APPROVAL
Earl W. Applbaum
 COUNTY REPRESENTATIVE 8-13-97


Research on file with County Remonumentation Representative.

C. Description of monument for corner and accessories established to perpetuate locating the position of the corner:

Corner is a 2" x 30" aluminum pipe with a 3" diameter aluminum cap stamped to read: COUNTY REMONUMENTATION; 1/4; S. 10, S. 15; T.50N, R.38W; 1997; P.S. 37273. Land is cleared and farmed to NW, SW, and SE of corner.

Witnesses:

- | | | | |
|-------------------|-----------------|----------|-----------|
| 5" Cedar | N 43° E | 53.18' | |
| 9" Poplar | N 82° E | 79.57' | |
| Steel Sign Post | South | 8.34' | (to face) |
| Steel Sign Post | North | 11.07' | (to face) |
| SE Corner Sec. 10 | S 88° 56' 00" E | 2615.90' | |
| SW Corner Sec. 10 | N 89° 42' 19" W | 2617.97' | |

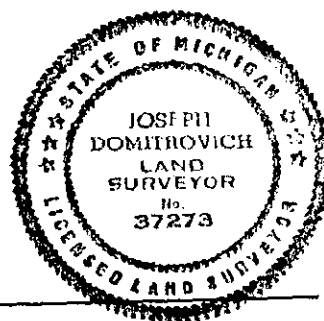

NOTE: Bearings are magnetic. Distances are to nail in side of witness objects unless noted.

Signed by J. C. Domitrovich
 Surveyor's Michigan License No. 37273

Date 8/13/97